


# T.6S.R.6W.W.M.

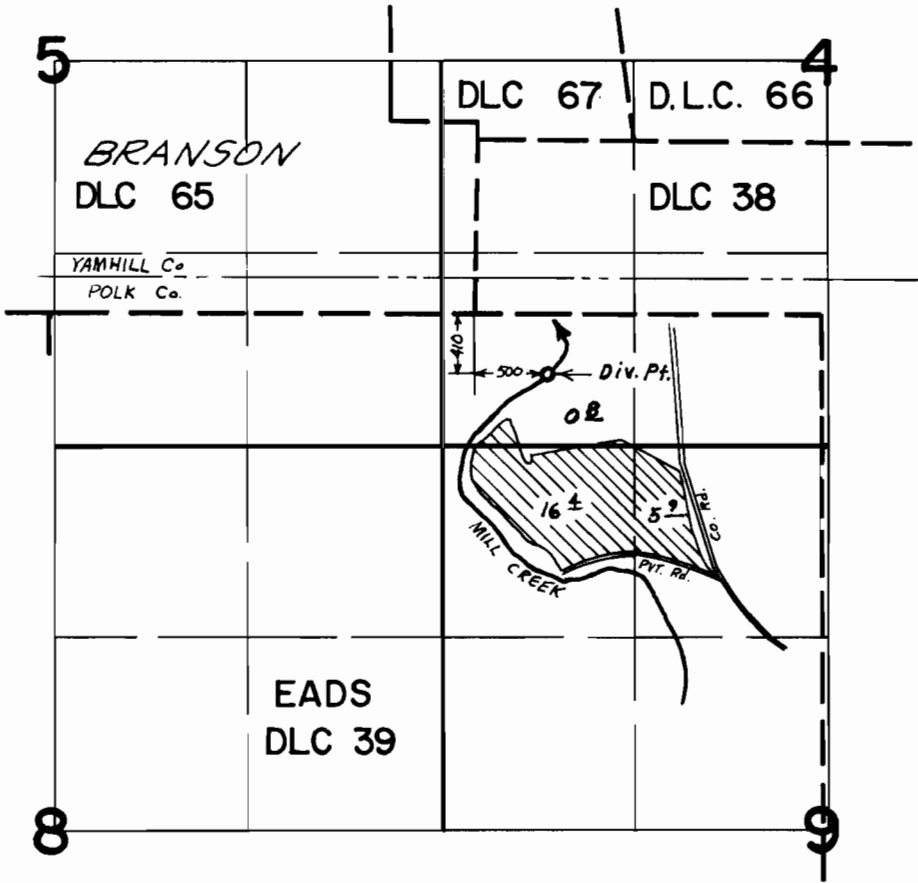

## FINAL PROOF SURVEY UNDER

Application No. 45389 Permit No. 33888  
IN NAME OF

RAYMOND L. RICE

Surveyed MAY 26 1972, by L. GOULD