T. 6 S. R. 4 W. W. M.

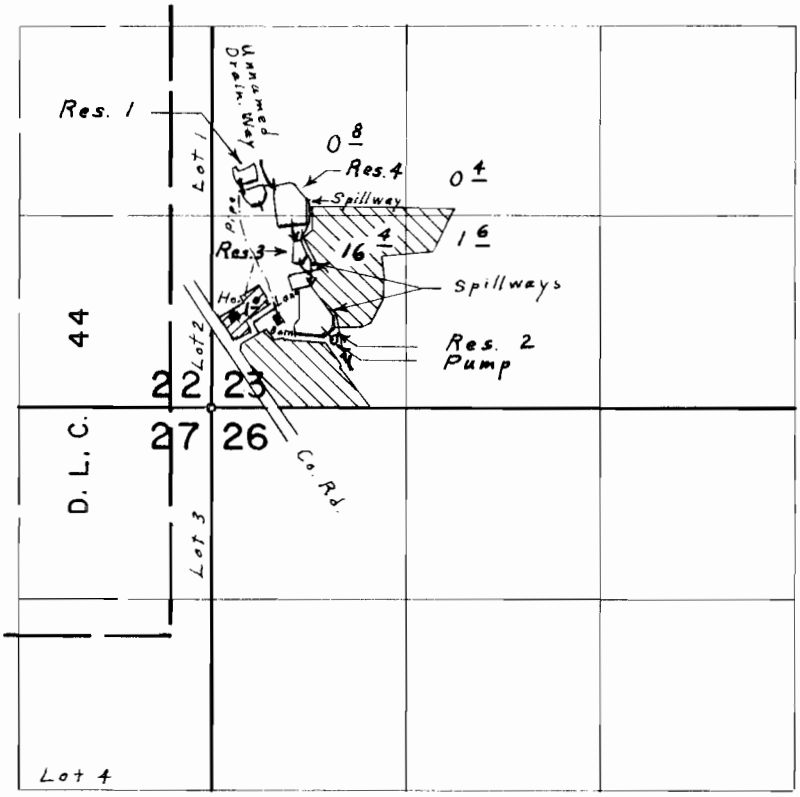

Div. Pts. located: 1530' N. & 180' E.; 1260' N. & 560' E.; 990' N. & 600' E.; 510' N. & 790' E.; all from S.W. Cor. Sec. 23

FINAL PROOF SURVEY
UNDER

Application No. R-45609 45610 Permit No. R-5384 33992

IN NAME OF

E. A. SOLLE

Surveyed April 26, 1972, by L. E. Gould

1972-S