


# T. 7 S. R. 4 W. W. M.

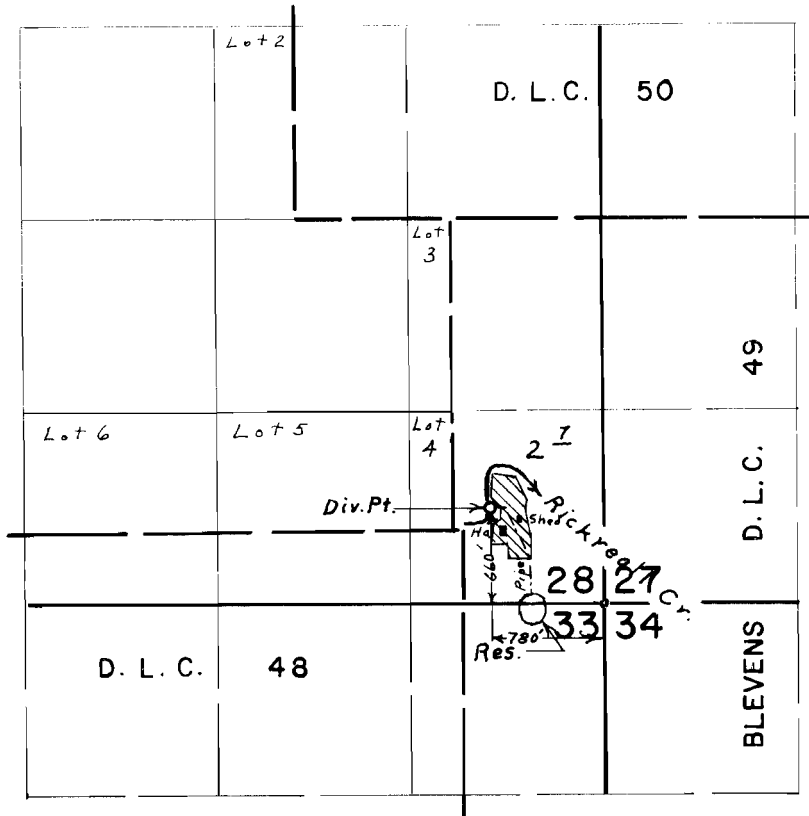

## FINAL PROOF SURVEY UNDER

R-46271                      R-5505  
 Application No. 46272      Permit No. 34568

IN NAME OF

LYLE E. BEYERS

Surveyed April 6, 1972, by L. E. Gould