


T. 7 S. R. 4 W. W. M.

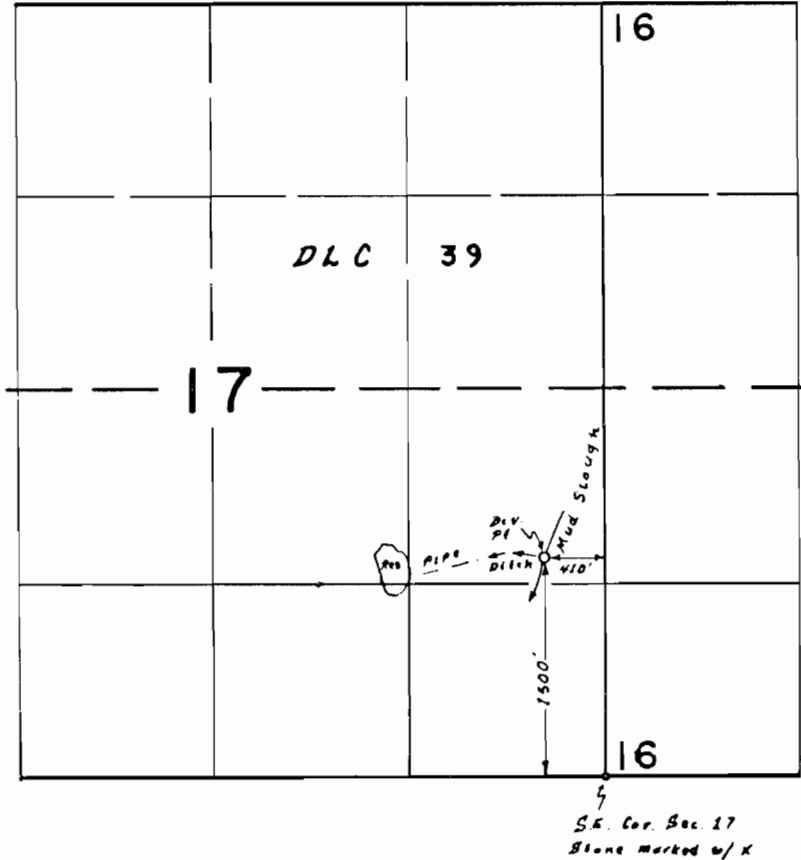

**FINAL PROOF SURVEY**  
UNDER

R. 47047 R-5642

Application No. 47048 Permit No. 35188  
IN NAME OF

Irene L. Rowland

Surveyed 15 June 1972, by L.E. Gould