


T. 7 S. R. 4 W. W.M.

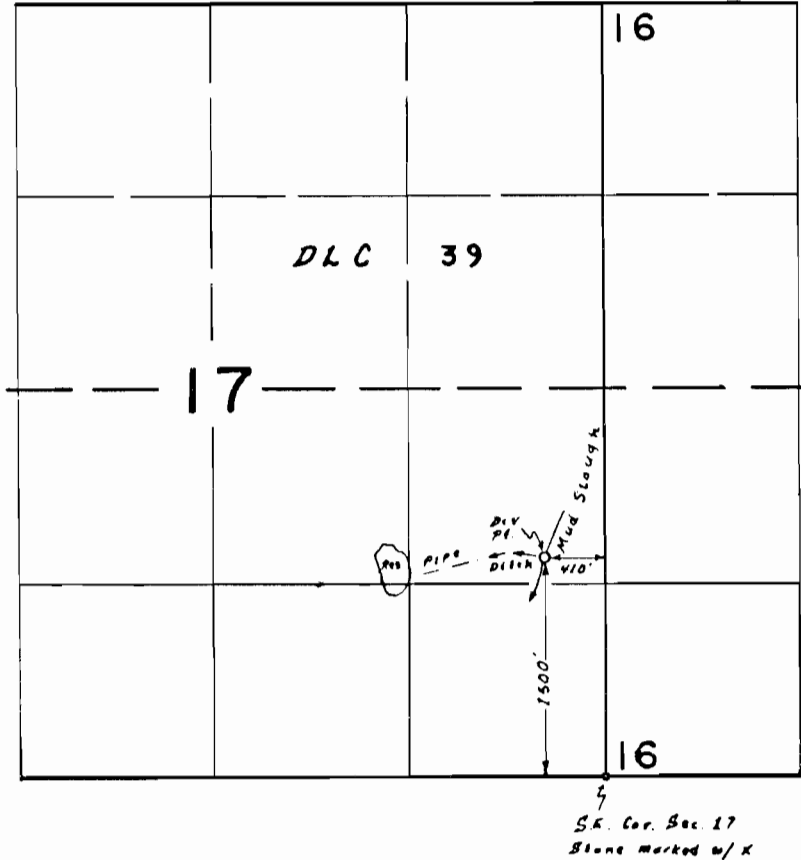

FINAL PROOF SURVEY
UNDER

R. 47047 R. 5642

Application No. 47048 Permit No. 35188
IN NAME OF

Irene L. Rowland

Surveyed 15 June 1972, by L.E. Gould