


T. 8 S. R. 6 W. W.M.

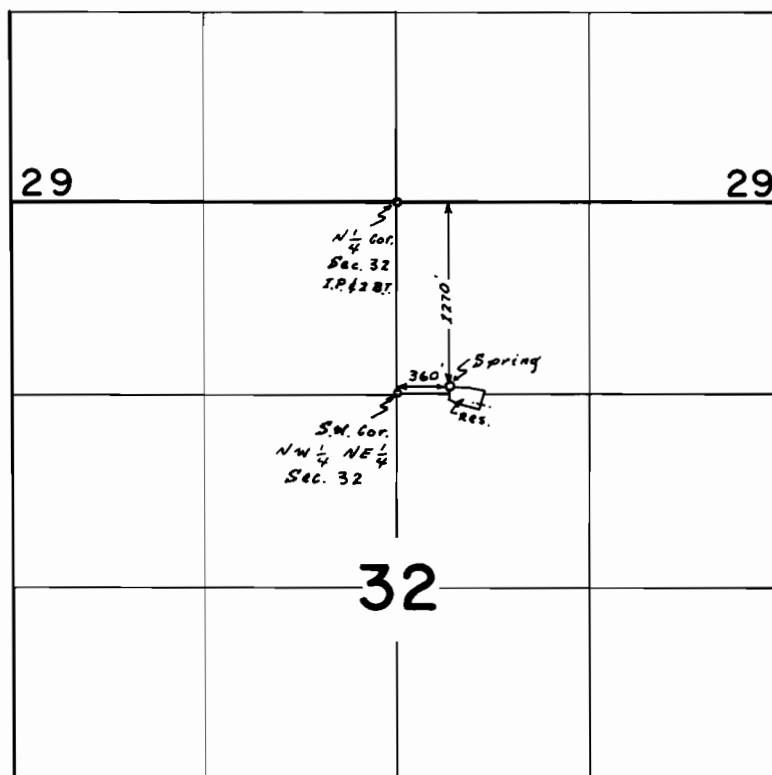

FINAL PROOF SURVEY
UNDER

Application No. 47360 Permit No. 35215
IN NAME OF
Falls City, a municipal corp.

Surveyed 20 Nov 1972, by L.E. Gould