


T.8S.R.6W. W.M.

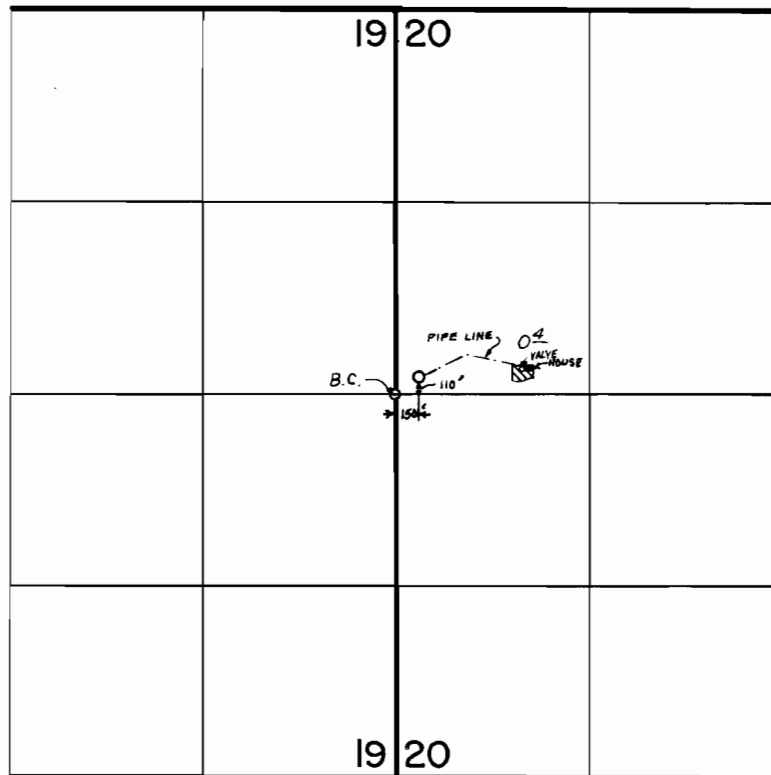

FINAL PROOF SURVEY
UNDER

Application No. 47151 Permit No. 35300
IN NAME OF

MR. & MRS. WILLIAM D. RESSER

Surveyed NOV 20 1972, by L. GOULD