


T. 7 S. R. 5 W. W.M.

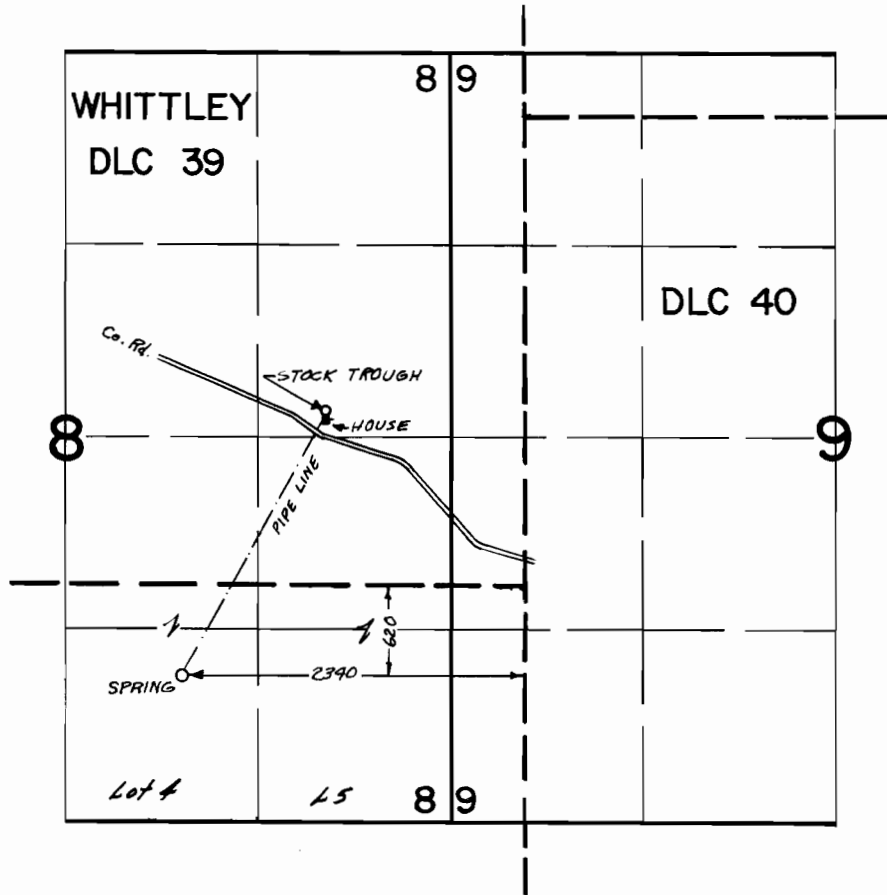

FINAL PROOF SURVEY
UNDER

Application No. 47520 Permit No. 35588
IN NAME OF

BERNHARD LANGE

Surveyed NOV 16 19 72, by L. GOULD