


# T.2S.R.44E.W.M.

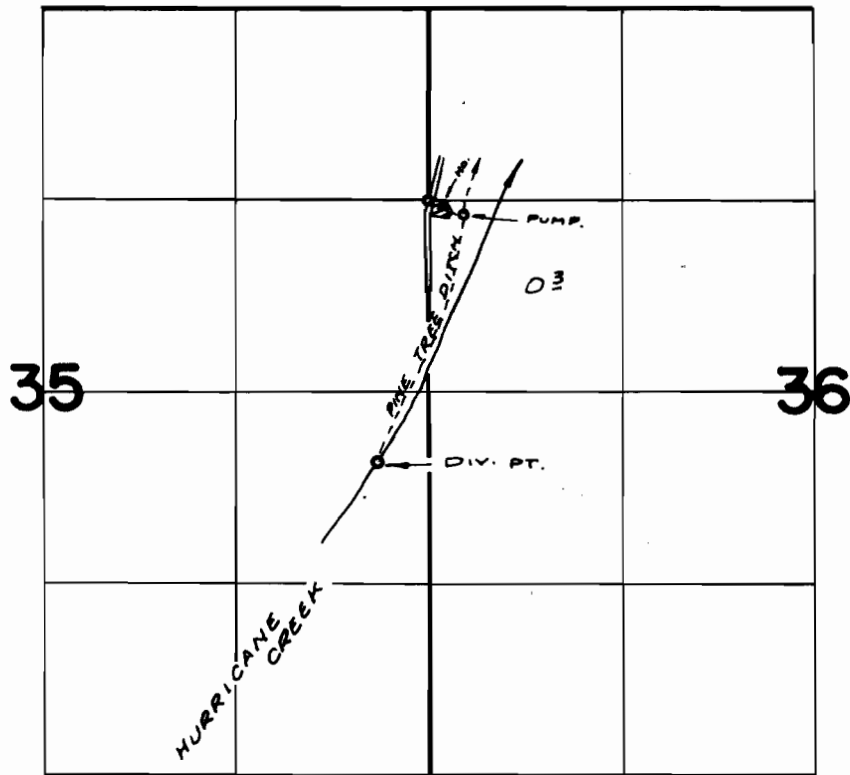

DIV. PT. LOC: S. 36°31' W. 588' FROM W  $\frac{1}{2}$  COR. SEC. 36

## FINAL PROOF SURVEY UNDER

Application No. 44131..... Permit No. 32600.....  
IN NAME OF

.....KATHRYN L. VOSCELYN.....

Surveyed JUNE 22 1972., by R. MUCKEN