


T. 3 S., R. 45 E., W.M.

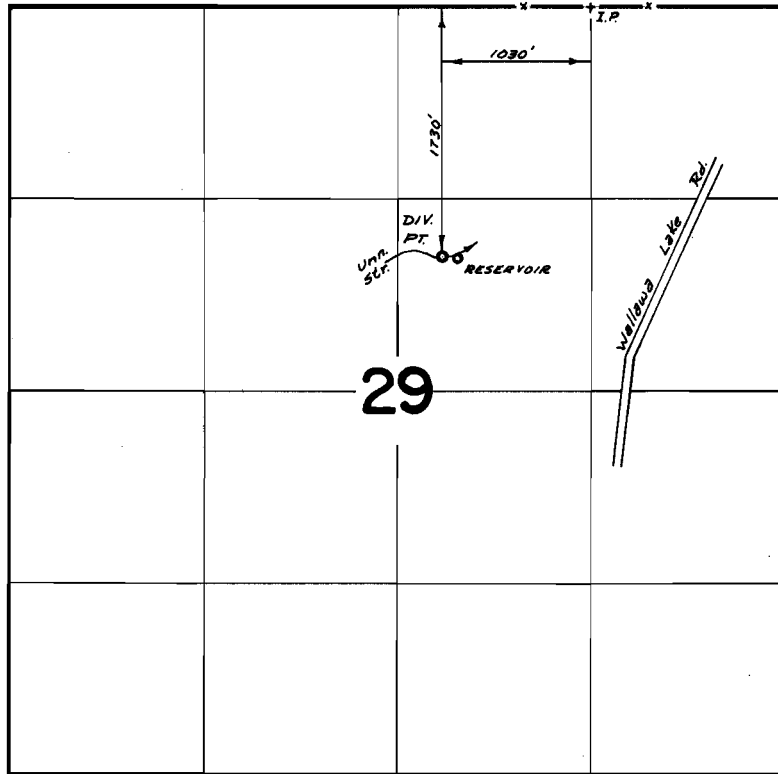

FINAL PROOF SURVEY UNDER

Application No. 44132 Permit No. 32961
IN NAME OF

CLARENCE K. MUMFORD

Surveyed June 22 1972, by L. E. Gould