


T.3S., R.44E., W.M.

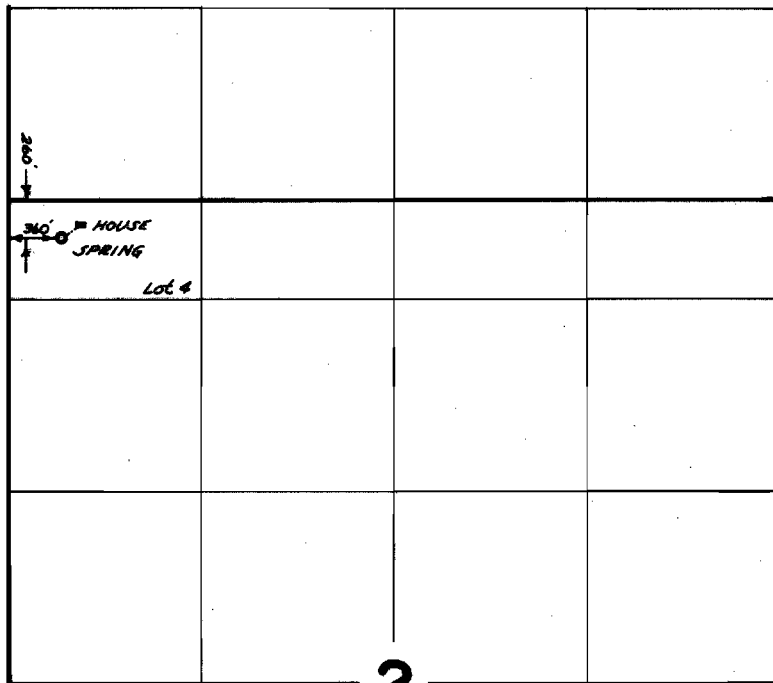

**FINAL PROOF SURVEY**  
UNDER

Application No. 45674 Permit No. 34056  
IN NAME OF

LYLE B. & VIOLA F. THORNTON

Surveyed June 27 1972, by L. E. Gould