


# T.2S.R.44E.W.M.

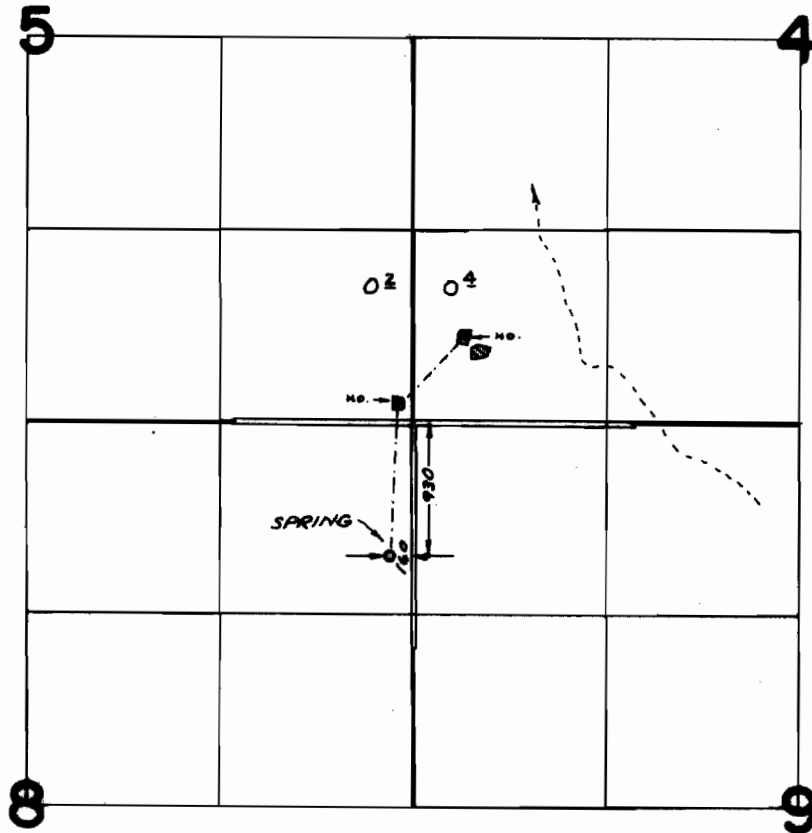

## FINAL PROOF SURVEY UNDER

Application No. 45830... Permit No. 34218...  
IN NAME OF

R. G. & CORA SIMON, W.M. & LAURA ODAM

Surveyed JUNE 20, 1972, by R. MUCKEN