


T.2S., R.44E., W.M.

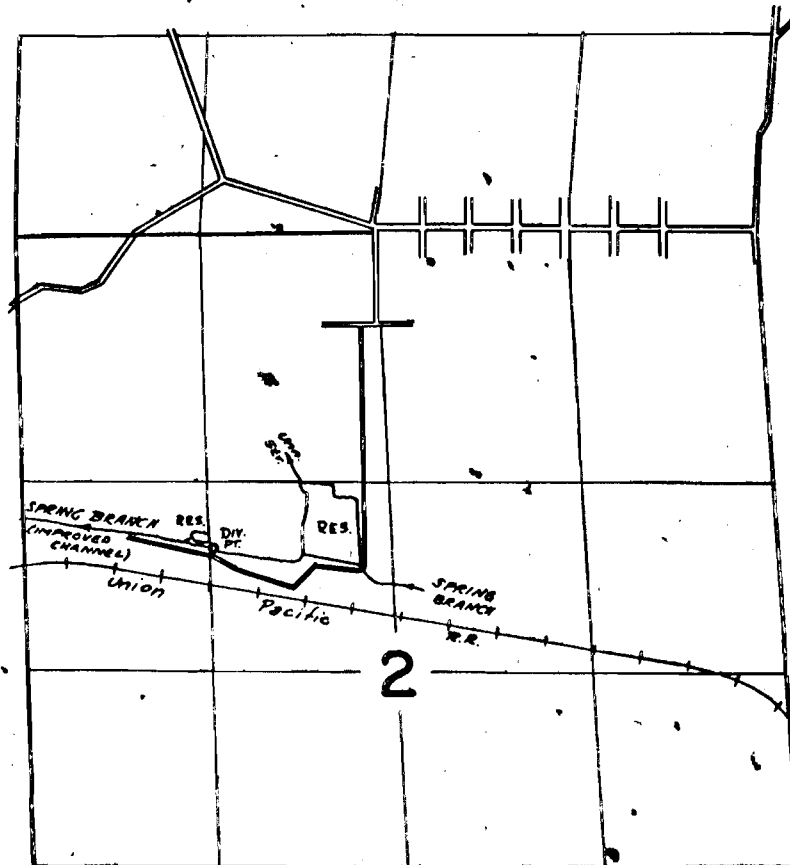

MARKER LOCATED: 2130' S. & 1360' E. FROM NW COR. SEC. 2.

FINAL PROOF SURVEY UNDER

R-46224 R-5499
Application No. 46922 Permit No. 34589
IN NAME OF

SAM W SHINN

Surveyed *June 26* 19*72*, by *L.E. Gould*