


T.2S., R.44E., W.M.

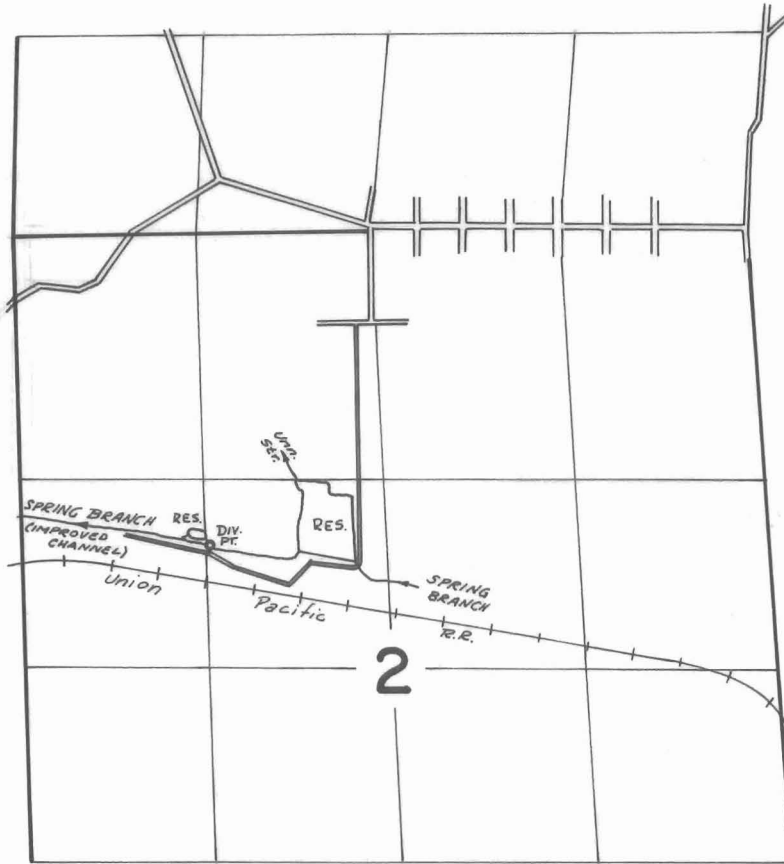

DIV. PT. LOCATED: 2130' S. & 1360' E FROM NW COR. SEC 2.

FINAL PROOF SURVEY UNDER

Application No. R-46224 46422 Permit No. R-5499 34589
IN NAME OF

SAM W. SHINN

Surveyed June 26 1972, by L. E. Gould