


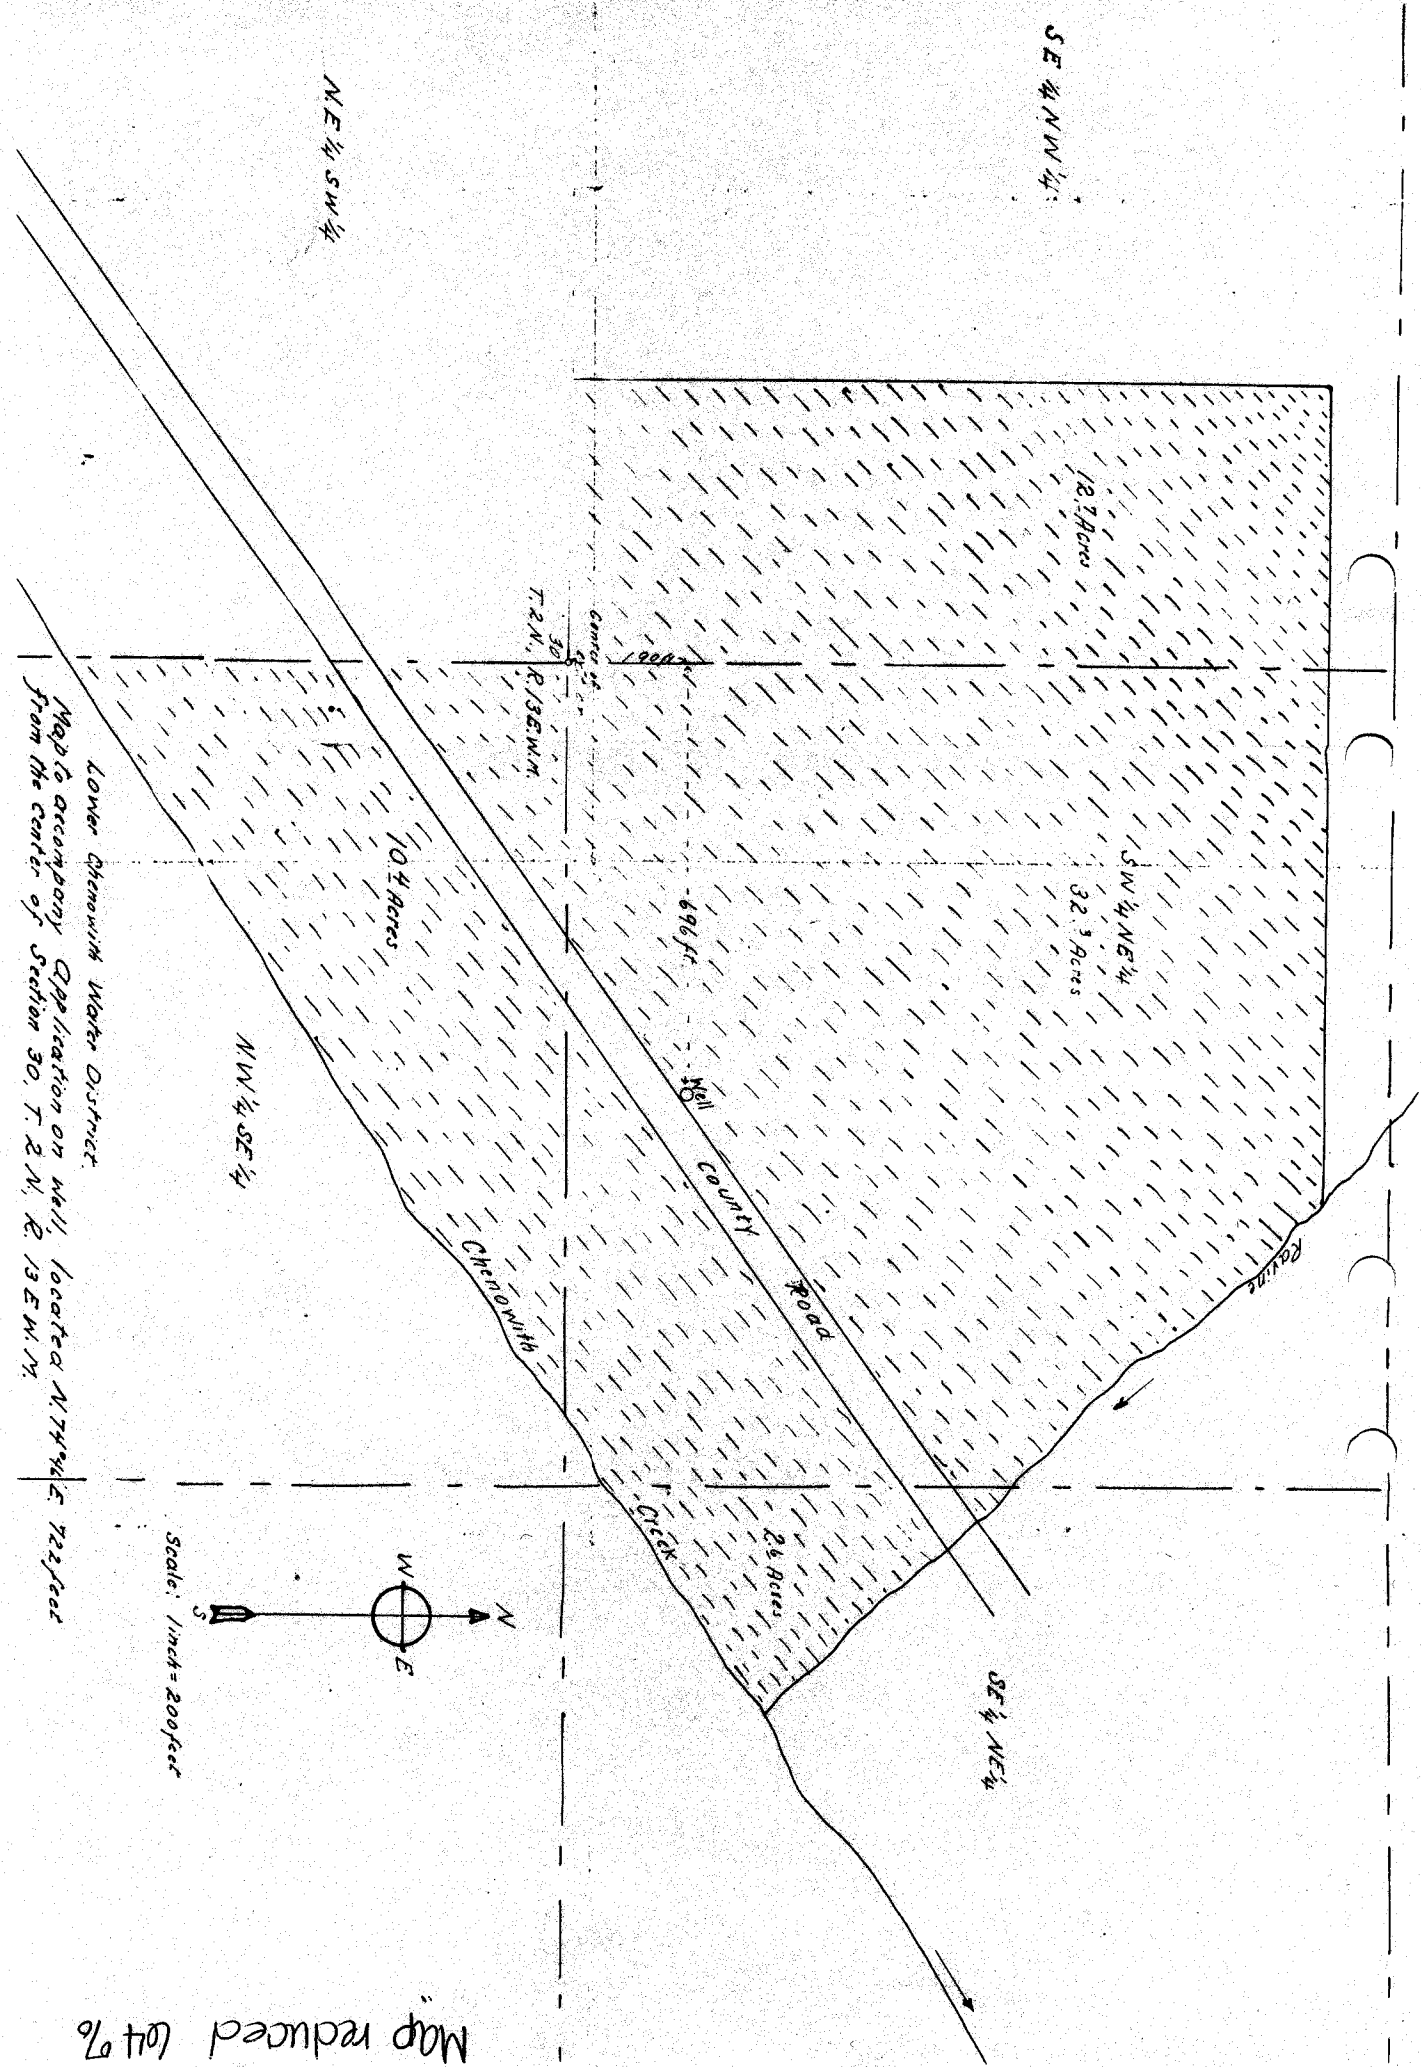

Map reduced 64%