


# T.5S.R.4W.W.M.

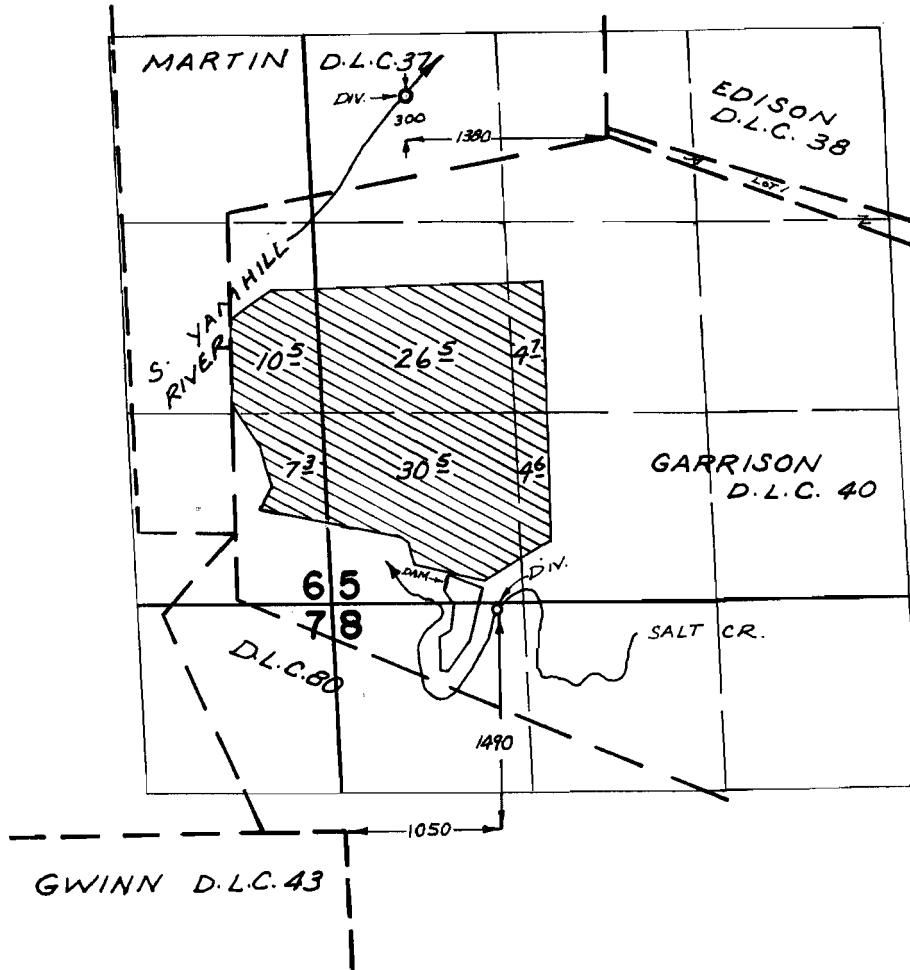

## FINAL PROOF SURVEY UNDER

41969                      31416  
R-43575                    R-5005  
Application No. 43576 Permit No. 32586  
IN NAME OF

CARL HOWARD

Surveyed MAY 17, 1972, by D. NORBY