


T.5S.R.4W.W.M.

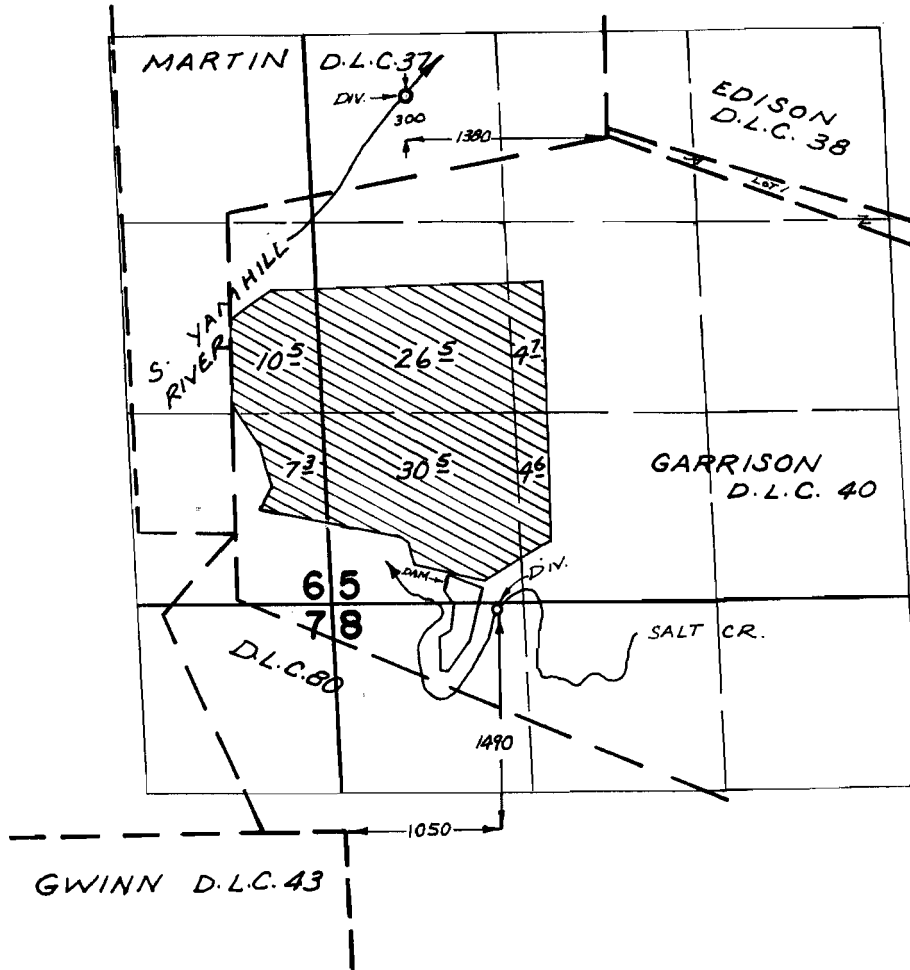

FINAL PROOF SURVEY UNDER

41969 31416
 R-43575 R-5005
 Application No. 43576 Permit No. 32586
 IN NAME OF

CARL HOWARD

Surveyed MAY 17, 1972, by D. NORBY