


T.28S.R.14W.W.M.

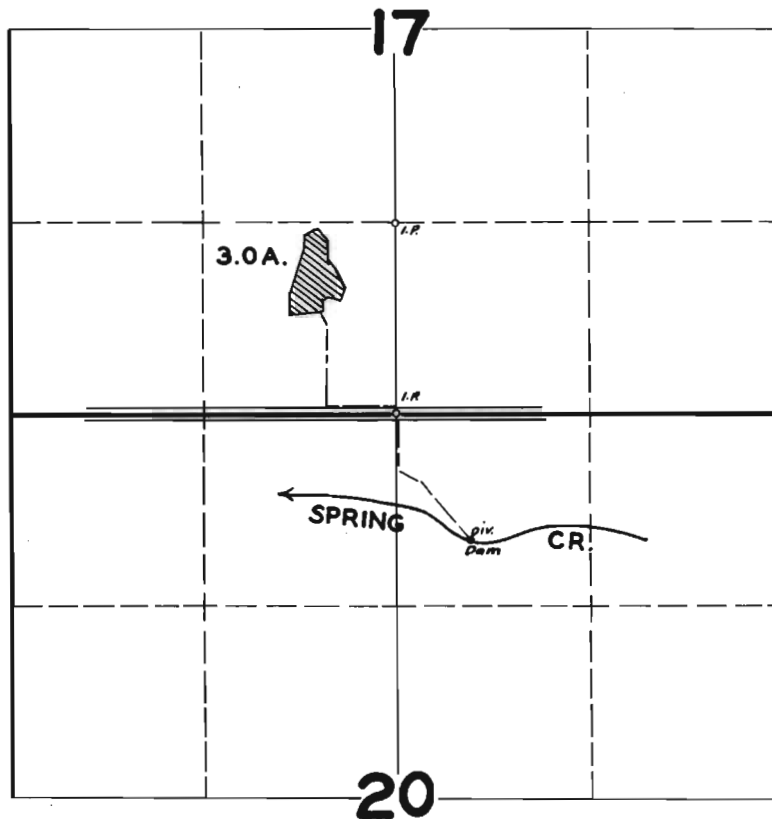

**FINAL PROOF SURVEY
UNDER**

Application No. 21162 Permit No. 16583

IN NAME OF

WILLIAM BIESCKE

Surveyed JUL. 25 1947, by JAS. E. BUNNELL