


T.29S.R.14W.W.M.

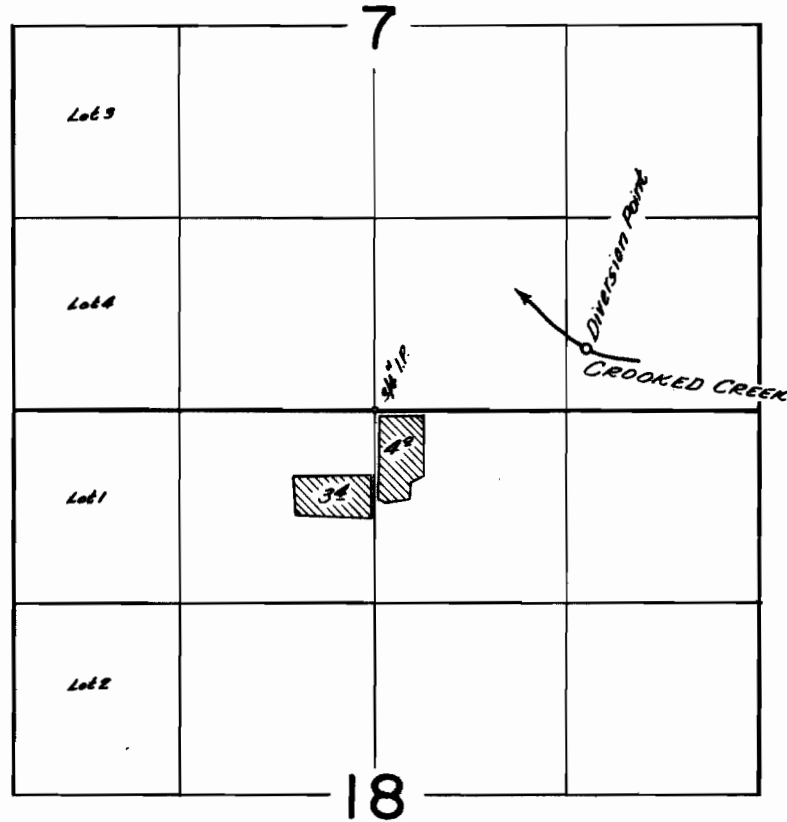

FINAL PROOF SURVEY
UNDER

Application No. 34219 Permit No. 26951
IN NAME OF

Frank H. & Viola M. Gould

Surveyed Aug. 14, 1963, by I. Lauer