


T. 25 S., R. 5 W., W.M.

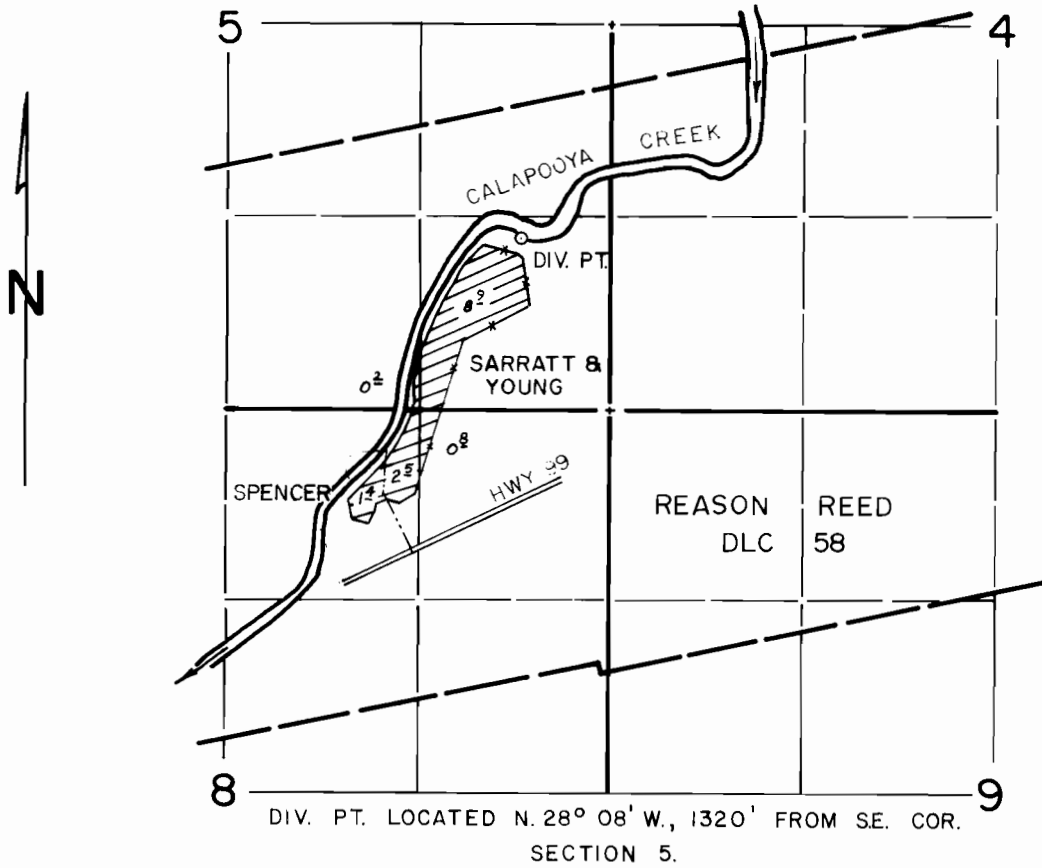

SCALE: 4" = 1 mile

FINAL PROOF SURVEY
UNDER

Application No. ...8928... Permit No. ...5847.....
IN NAME OF

SPENCER, SARRATT AND YOUNG...

Surveyed AUG...13. 19.84, by *L.E. Cashion*.....