


E-415

T. 13 S. R. 29 E.

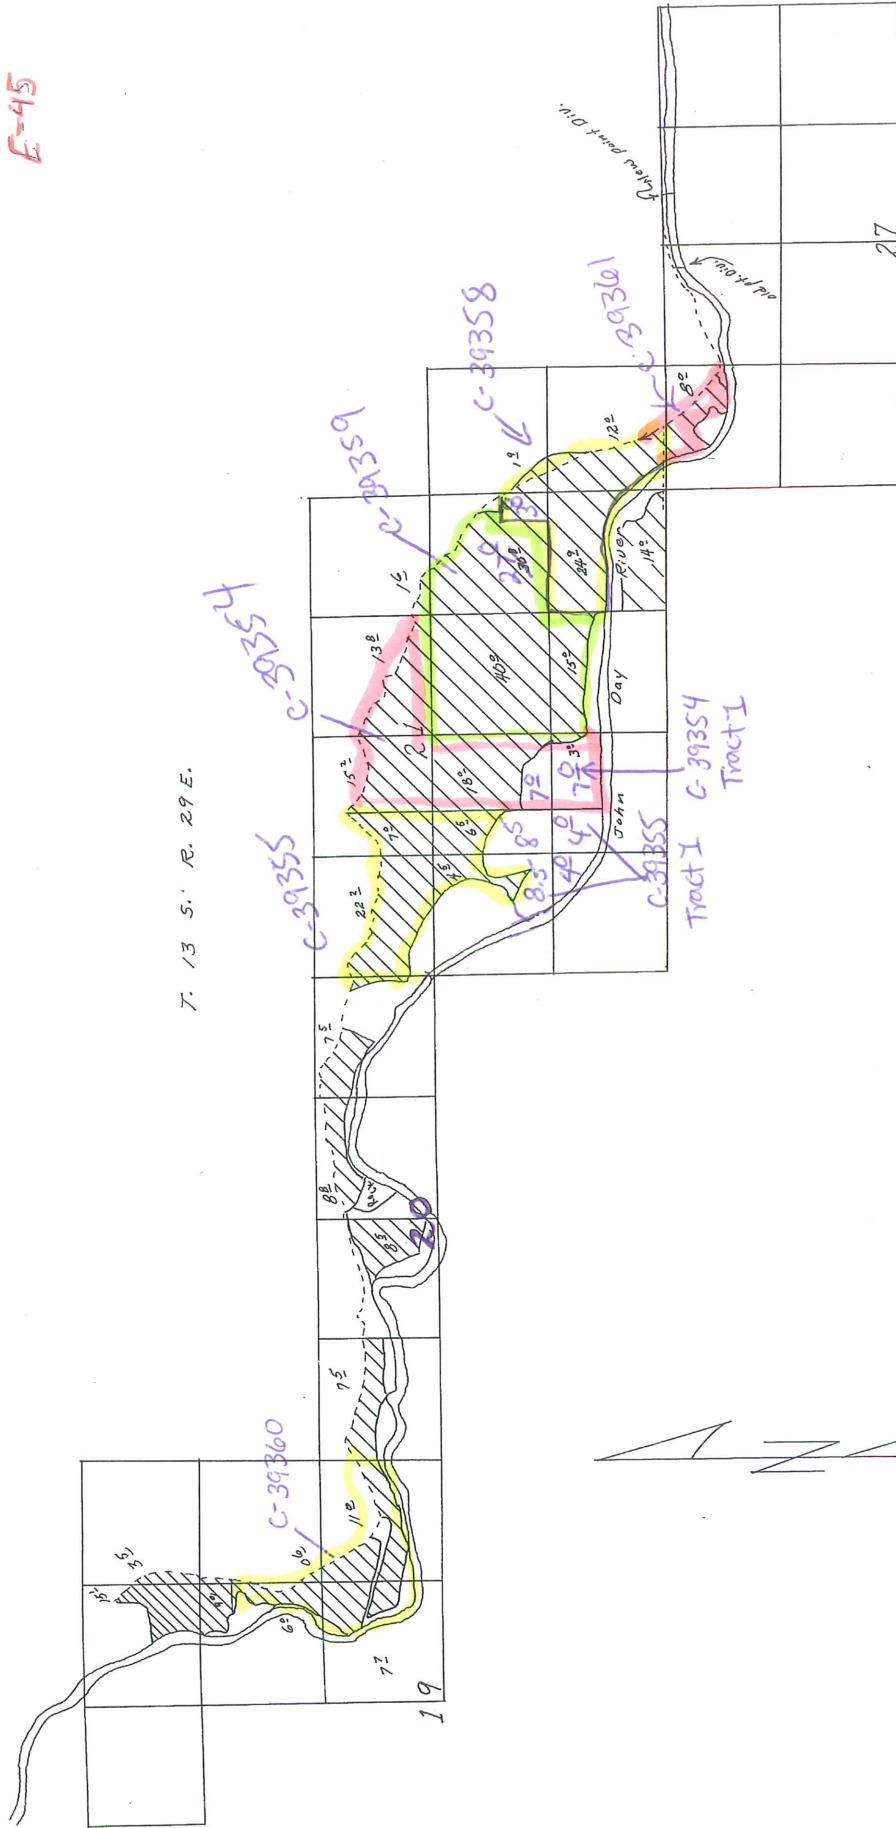

**RECEIVED**  
 JUN 2 1966  
 STATE ENGINEER  
 PORTLAND, OREGON

Scale 4" = Mile

Application Map