


T.13 S.R. 29E.W.M.

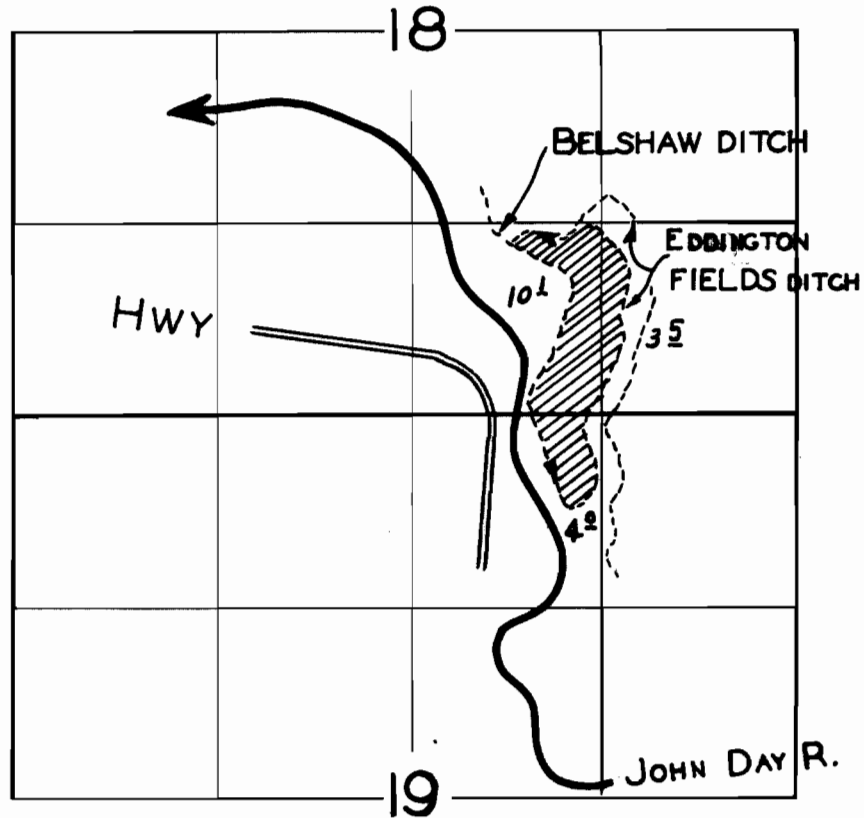

FINAL PROOF SURVEY

UNDER

Application No. 23880 Permit No. 18828

IN NAME OF

Katherine Geisler

Surveyed Aug 31, 1954, by H.L. Coffman

G6-15