


T. 9 S. R. 27 E. W.M.

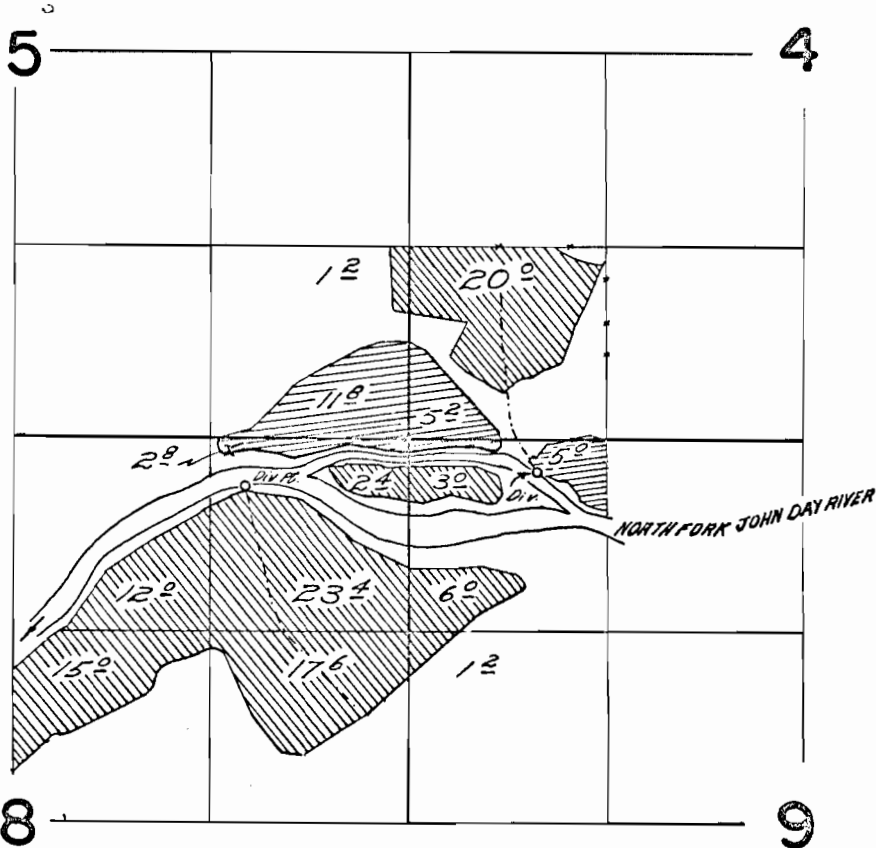

DIVERSION POINTS LOCATED 1650 F.F.S. & 2450 F.F.W.; &
1450 F.F.S. & 470 F.F.W.; BOTH FROM N.E. CORNER
SW 1/4 SW 1/4 SECTION 4.

 TRANSFER C-128

PERMIT 26207 

FINAL PROOF SURVEY
UNDER

TRANSFER C-128

Application No. 33138.. Permit No. 26207
IN NAME OF

W. & E. Miller Ranch, Inc.

Surveyed *July 10, 1964*, by *George M. Ward*
May 15, 1968 by *W. d. Ruppert*