


T.39S.R.10E.W.M.

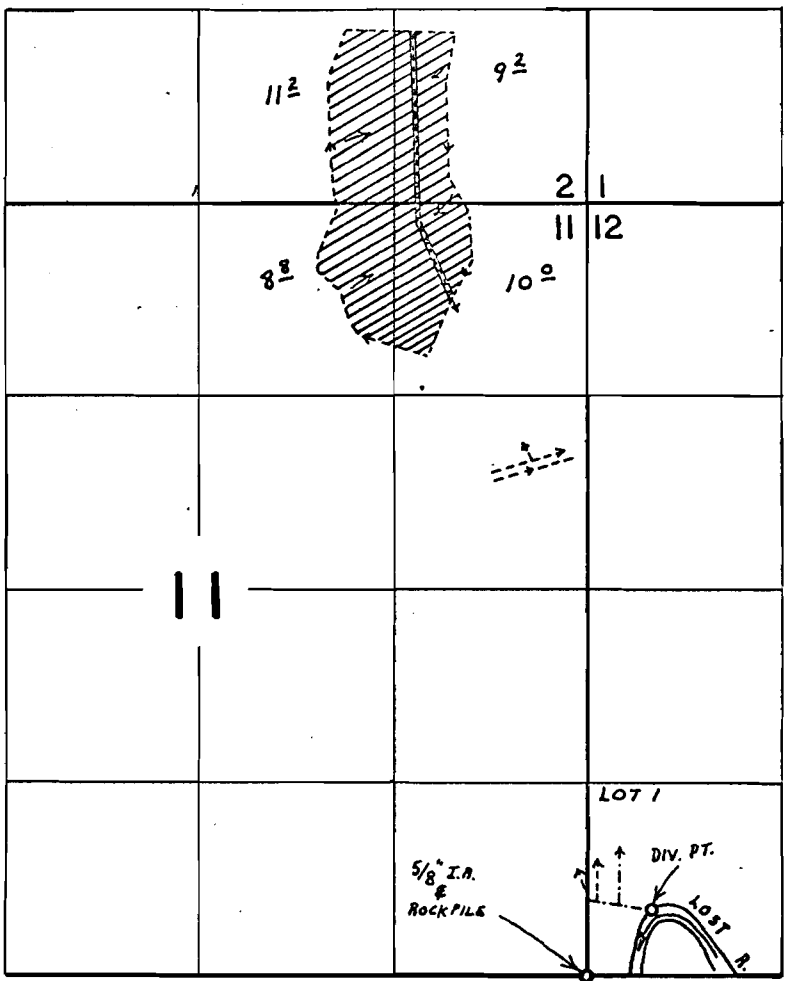

DIV. PT. LOC. 450' N. & 450' E. FROM SE COR. SEC. 11

FINAL PROOF SURVEY

UNDER
TRANSFER NO. S-162

Application No. _____ Permit No. _____

IN NAME OF

PAUL H. FAIRCLO

Surveyed SEPT. 15 19 70, by G. BACA