


T. 34S. R. 2 E. W.M.

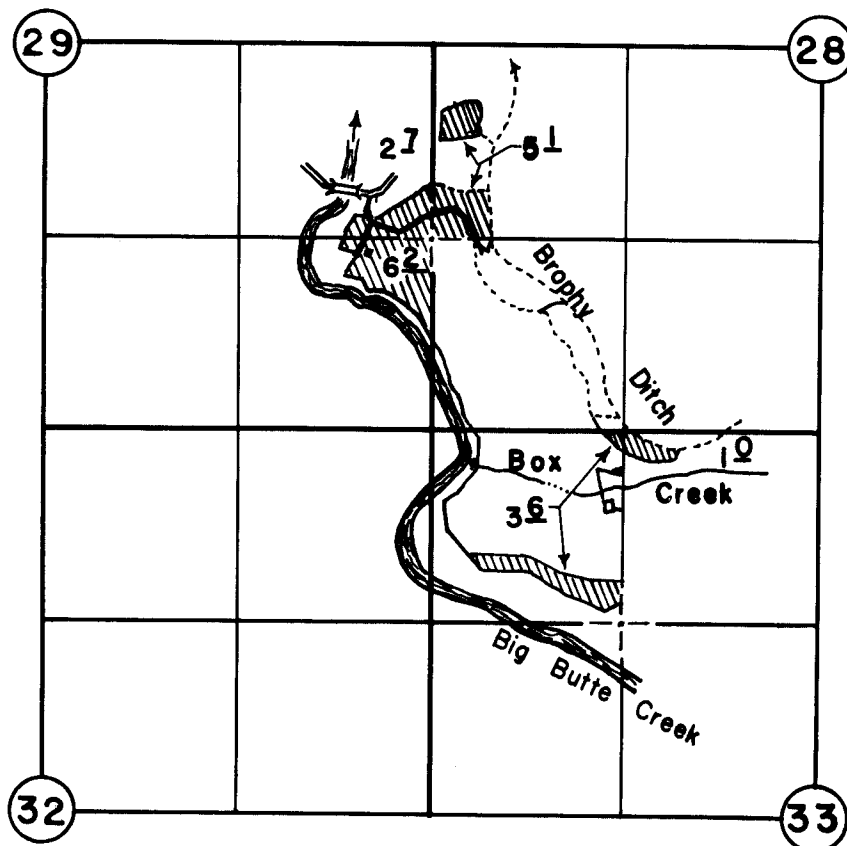

FINAL PROOF SURVEY
UNDER

Trans. No. B-203
Application No. Permit No.
IN NAME OF

..... Daniel Johnston

Surveyed Oct. 8 1971 .. by D.C. Hendrix