


T.5S.R.5W.W.M.

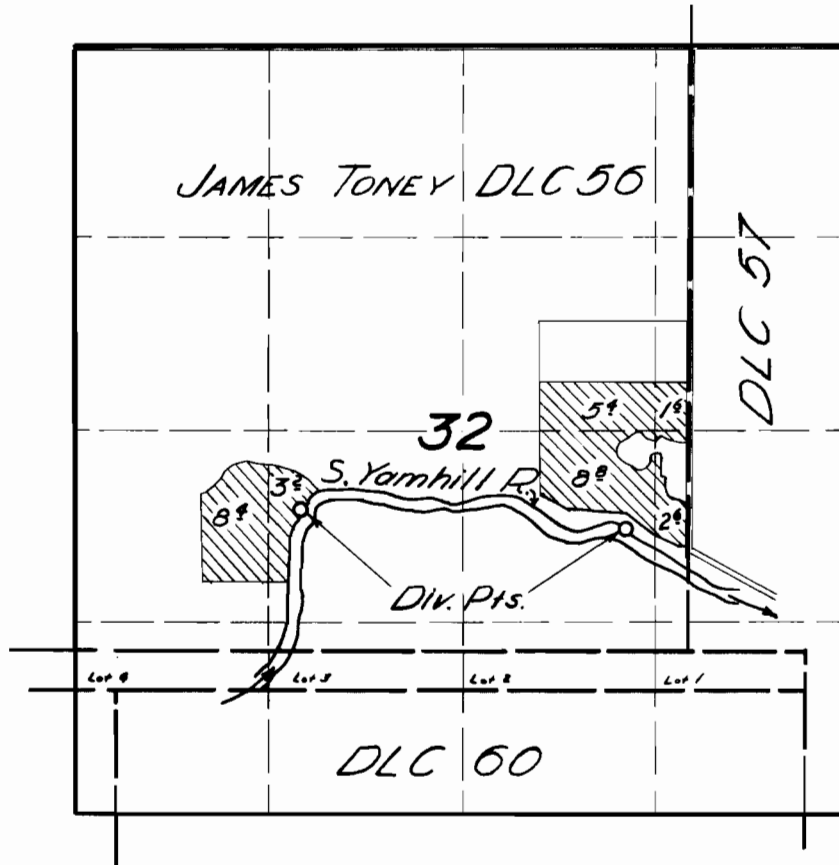

FINAL PROOF SURVEY
UNDER

Application No. 26384 Permit No. 20701

IN NAME OF

A. C. CAMP

Surveyed 22 Mar. 1956, by *C. M. Wilby*