


T.7S. R.45E. W.M.

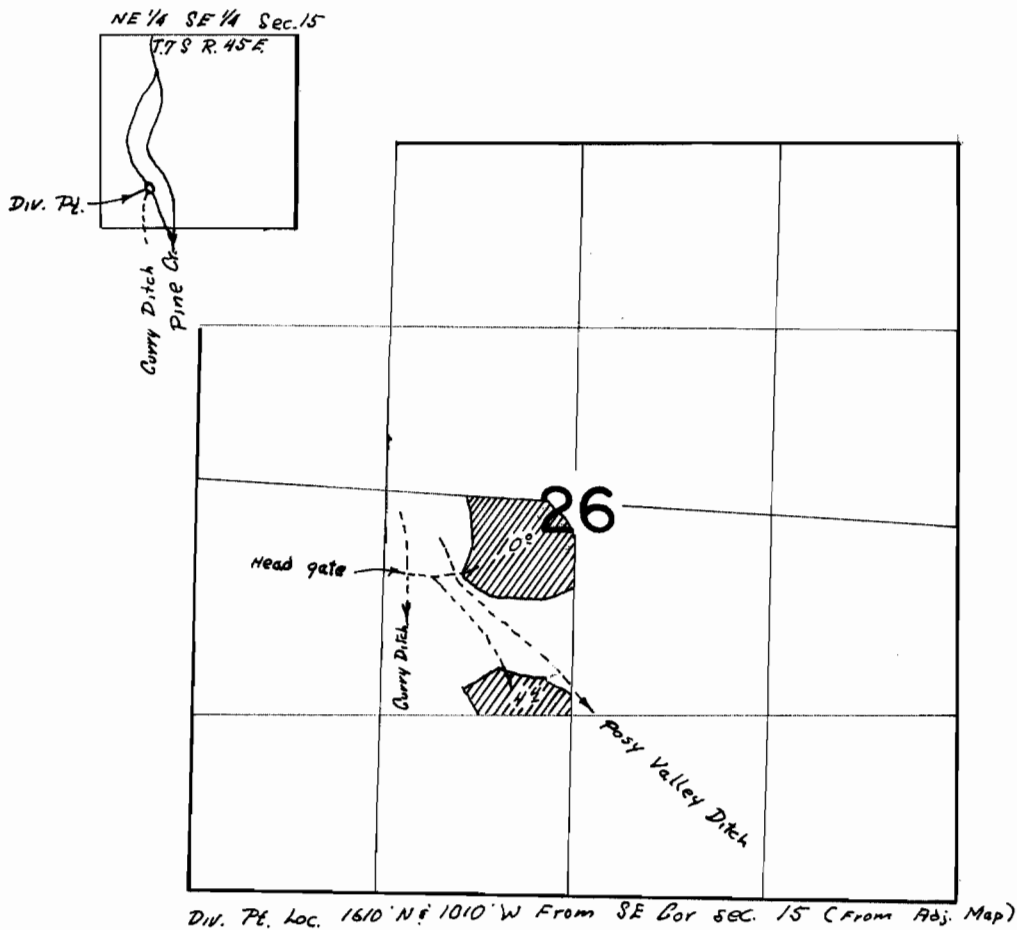

FINAL PROOF SURVEY
UNDER

Application No. 39280 Permit No. 29255
IN NAME OF

PERCY RITTER

Surveyed June 22 1972, by R.G. Mucken