


T.9S. R.45E. W.M.

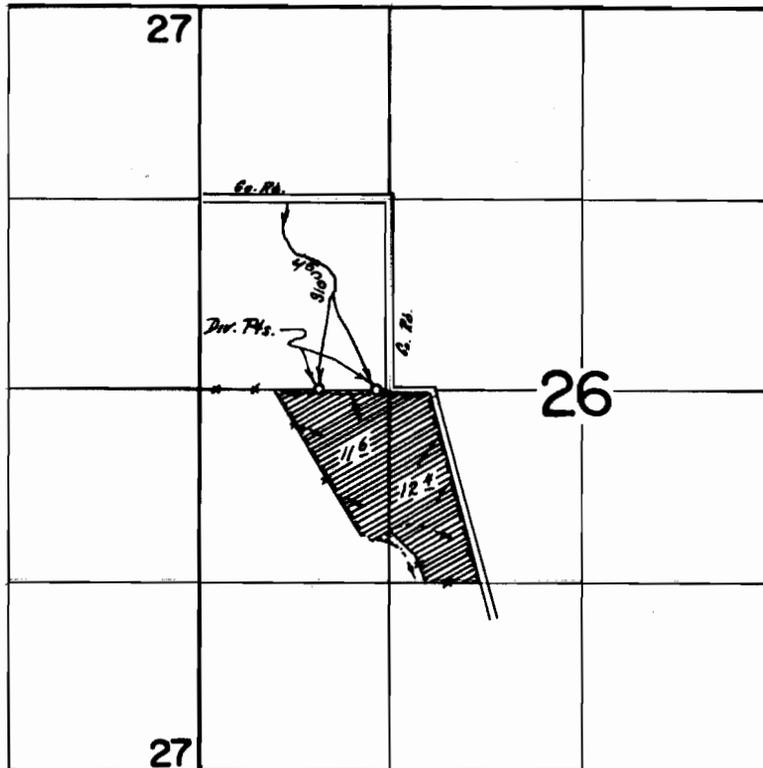

Div. Pks. Loc. 490' W of 90' W. From NE Cor. NW 1/4 SW 1/4 Sec. 26

**FINAL PROOF SURVEY**  
UNDER

Application No. 12626 Permit No. 31842

IN NAME OF

R. R. GRAVEN

Surveyed June 22 1972, by P. B. Mucken