


T.28 & 29 S.R.12W.W.M.

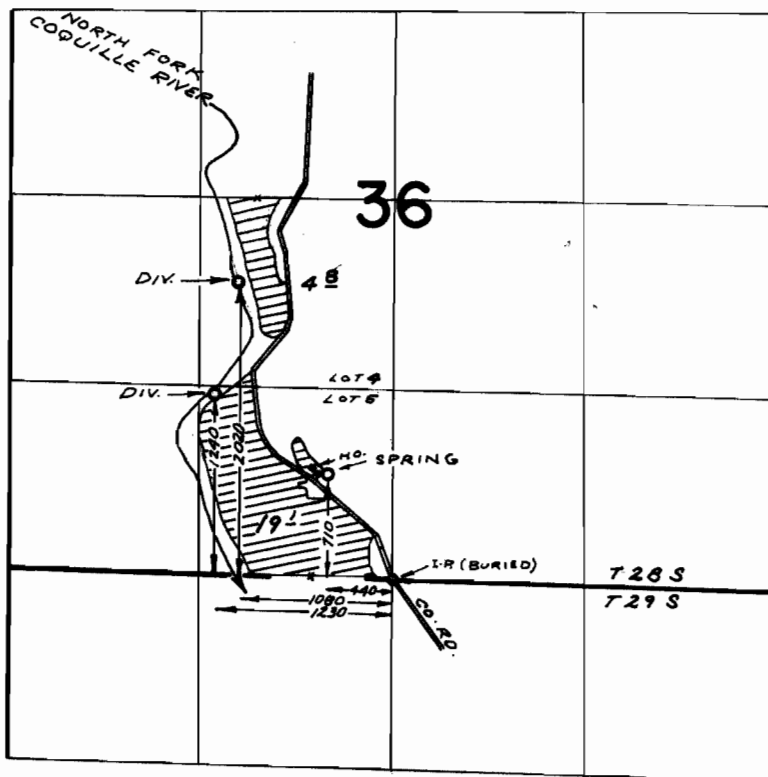

FINAL PROOF SURVEY
UNDER

Application No. 29473 Permit No. 29306
IN NAME OF

ZENO BRIGHT

Surveyed JULY 17, 1972, by R. MUCKEN