


# T.28S.R.12W.W.M.

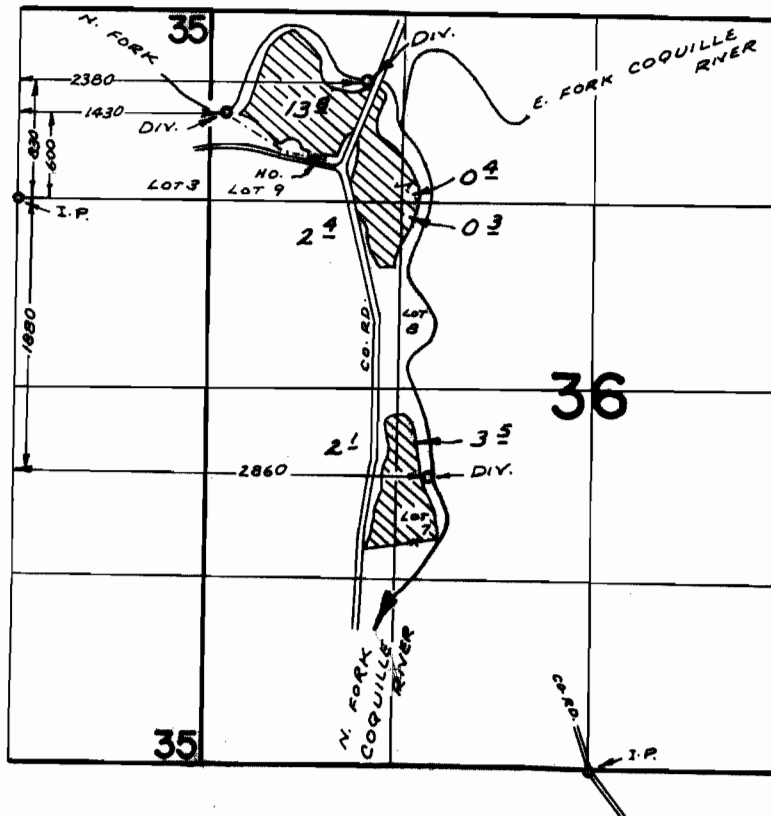

## FINAL PROOF SURVEY UNDER

Application No. 29479 Permit No. 29309  
IN NAME OF

PAUL L. DAVIS

Surveyed JULY 20, 1972, by R. MUCKEN