


T.28S.R.12W.W.M.

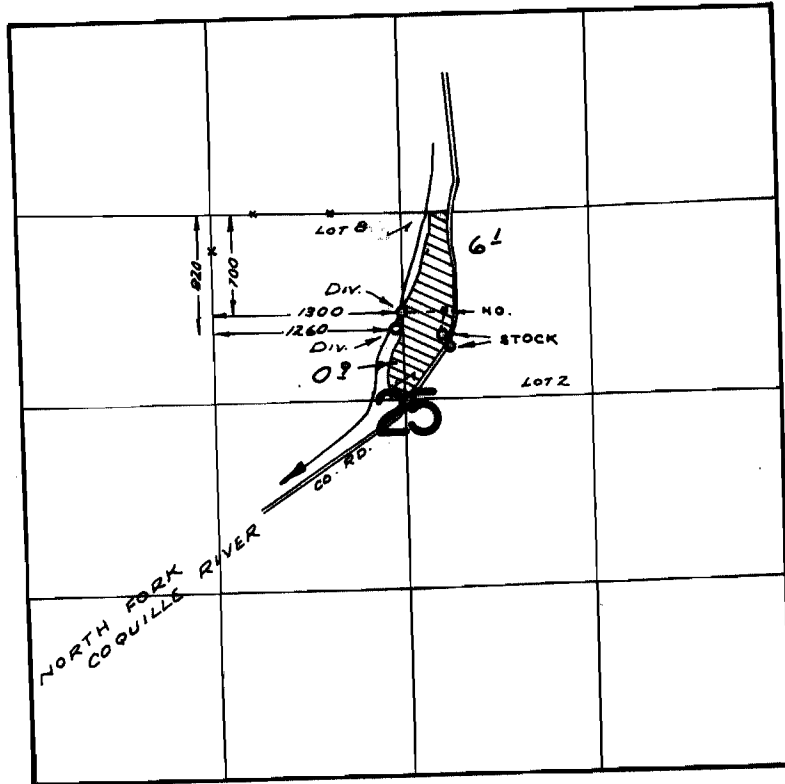

FINAL PROOF SURVEY
UNDER

Application No. 29491 Permit No. 29315
IN NAME OF

NELSON R. REISS

Surveyed JULY 18, 1972, by R. MUCKEN