


T. 28 S. R. 12 & 13 W. W. M.

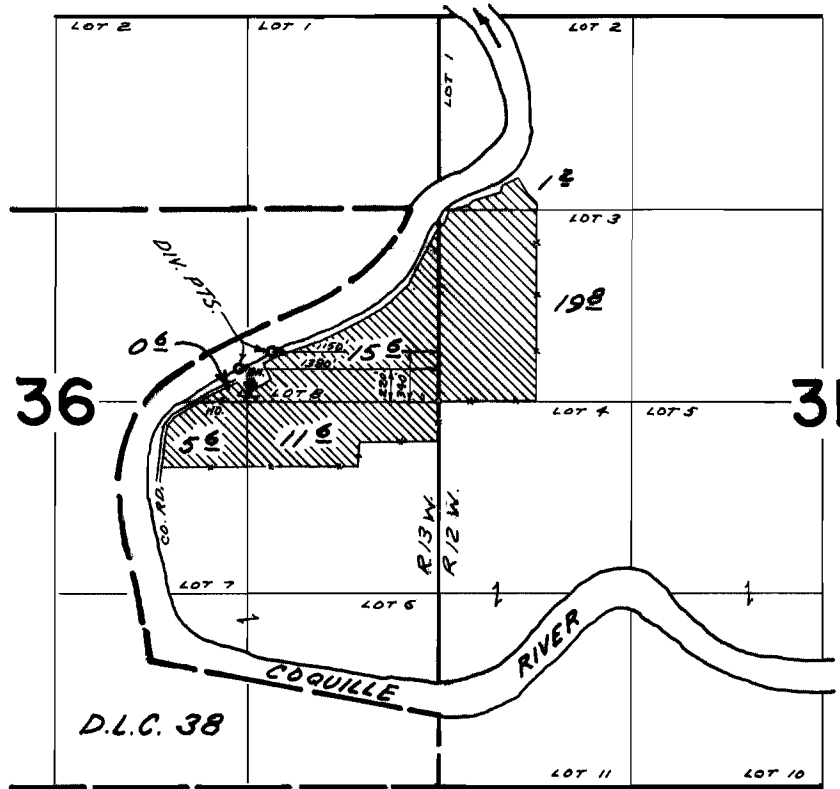

FINAL PROOF SURVEY UNDER

Application No. 39518 Permit No. 29325
IN NAME OF

DONALD C. PETERSON

Surveyed AUG. 29 1969, by D. BUELL
JULY 20 1972 R. MUCKEN