


T. 30S. R. 10W. W.M.

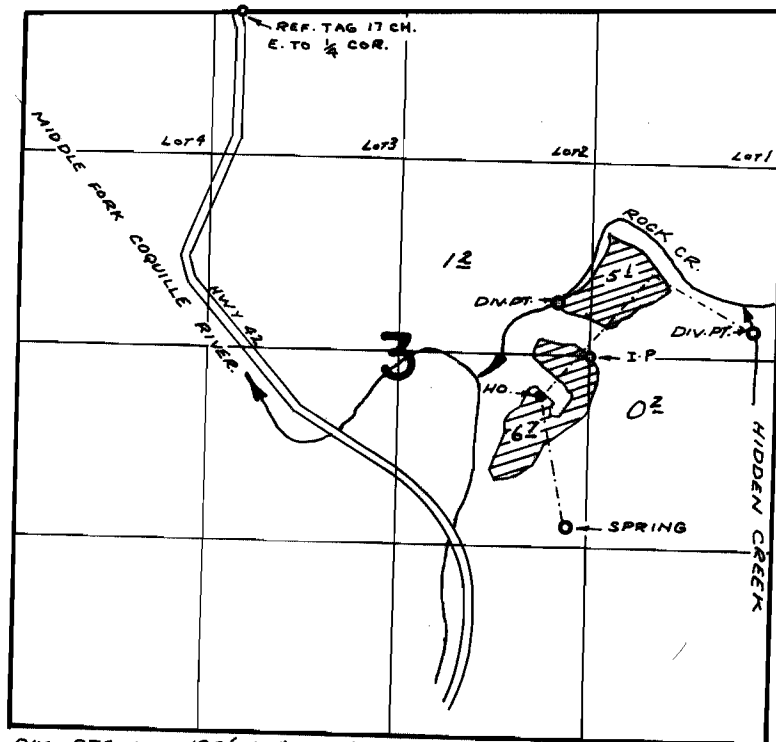

DIV. PTS. LOC: 190' N. & 1120' E.; 360' N. & 220' W. SPRING:
1180' S. & 130' W., ALL FROM S.W. COR. SE 1/4 NE 1/4 SEC. 3

FINAL PROOF SURVEY
UNDER

Application No. ³⁹⁵⁸³~~40773~~ Permit No. ²⁹³²⁸~~30359~~
IN NAME OF

CLARENCE V. BLOYD

Surveyed SEPT 18, 1969, by D. BUELL
JULY 14, 1972 by R. MUCKEN