


T.28S.R.12W.W.M.

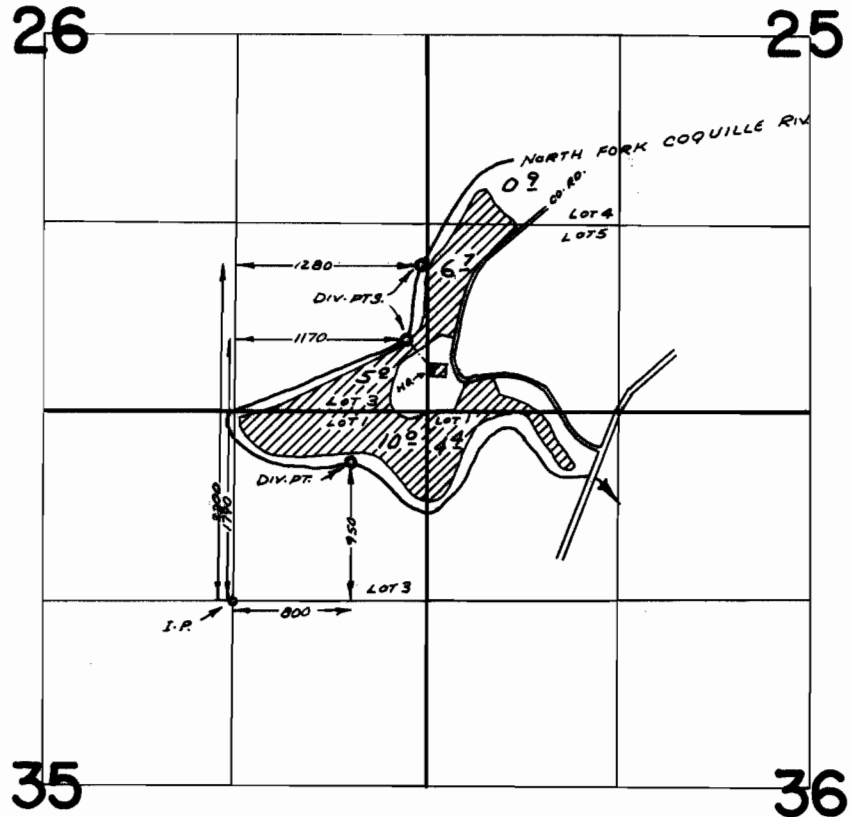

**FINAL PROOF SURVEY**  
UNDER

Application No. 22507 Permit No. 27400  
IN NAME OF

D. J. KIRKLAND OR EVELYN KIRKLAND

Surveyed JULY 18 1972, by R. MUCKEN