


T.27S., R.12W., W.M.

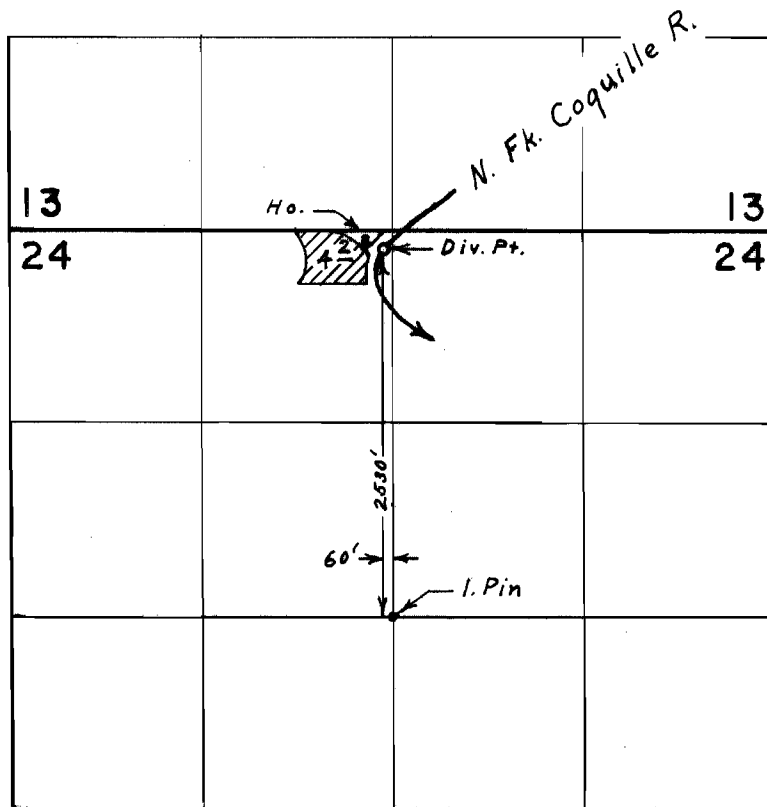

FINAL PROOF SURVEY
UNDER

Application No. 39624 Permit No. 29443
IN NAME OF

L. L. & JUNE M. ROSS

Surveyed July 11, 1972, by L. E. Gould