


T.29S.R.12W.W.M.

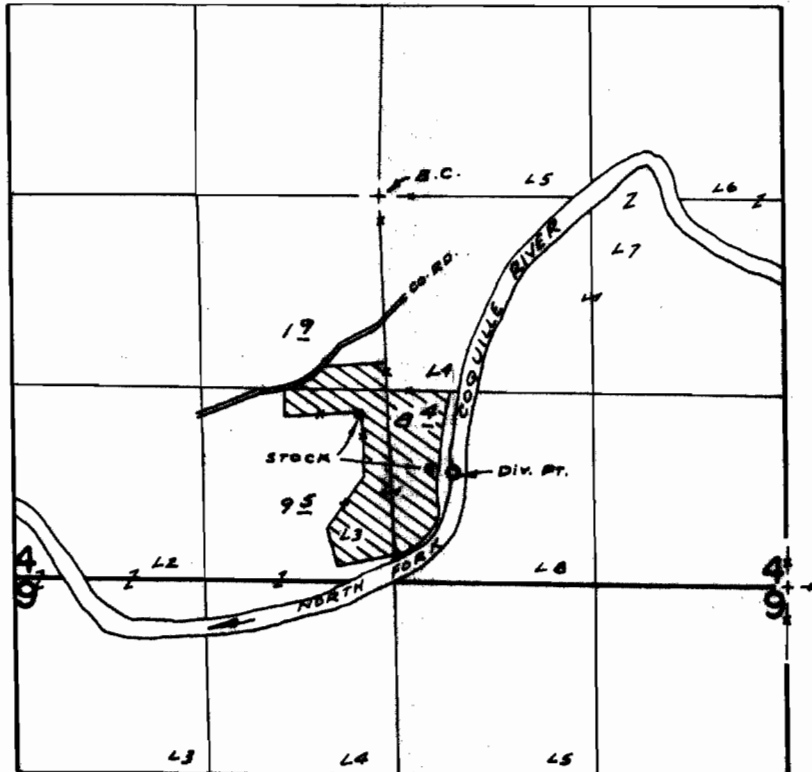

DIV. PT. LOC: 550'S. & 460'E FROM N.W. COR. LOT 3 (SW 1/4 SE 1/4) SEC. 4

FINAL PROOF SURVEY
UNDER

Application No. 29757 Permit No. 29490
IN NAME OF

FRED A. LEWIS

Surveyed July 19, 1972 by R. MUGGEN