


T. 30S.R. 10W.W.M.

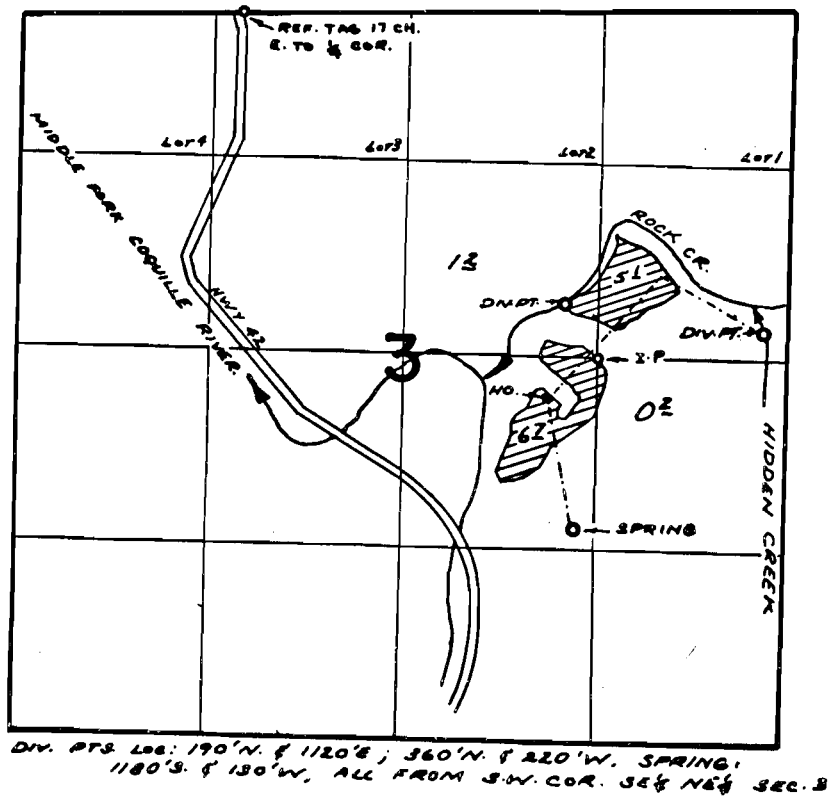

FINAL PROOF SURVEY
UNDER

Application No. ³⁹⁵⁸³40773 Permit No. ²⁹³²⁸30259
IN NAME OF

CLARENCE V. BLOYD

Surveyed SEPT 18, 1969, by D. BUELL
JULY 14, 1972 by R. MUCKEN