


T. 29S. R. 13W. W.M.

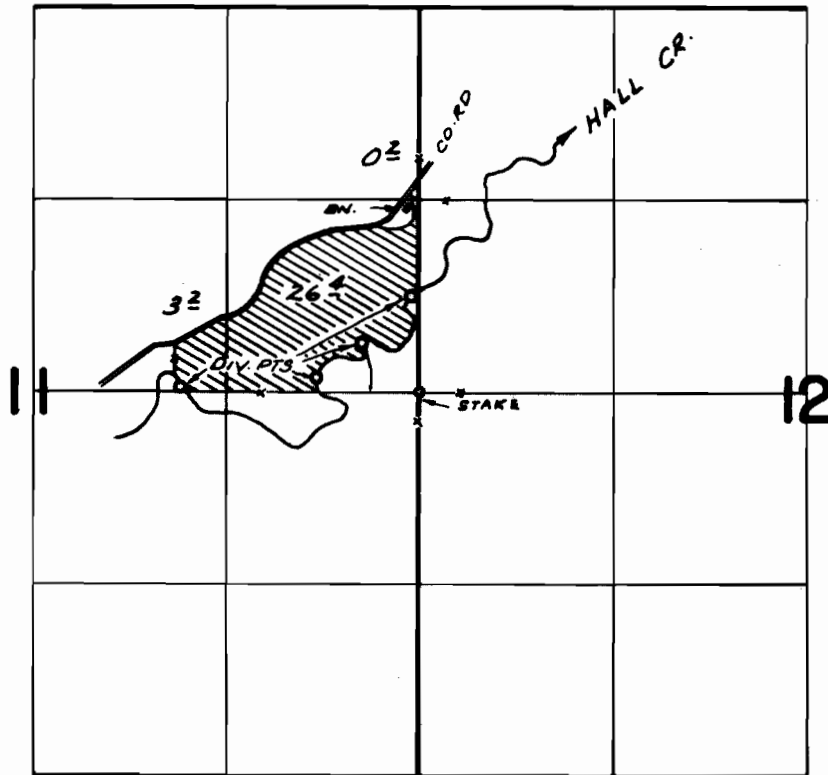

DIV. PTS. LOC: 30' N. & 1630' W.; 100' N. & 700' W.; 330' N. & 380' W.; 660' N. & 50' W, ALL FROM E. & COR. SEC. 11

FINAL PROOF SURVEY UNDER

Application No. 41236 Permit No. 30788
IN NAME OF

LYNN SCHRADER

Surveyed JULY 21, 1972, by R. MUCKEN