


T. 31 S. R. 12 W. W.M.

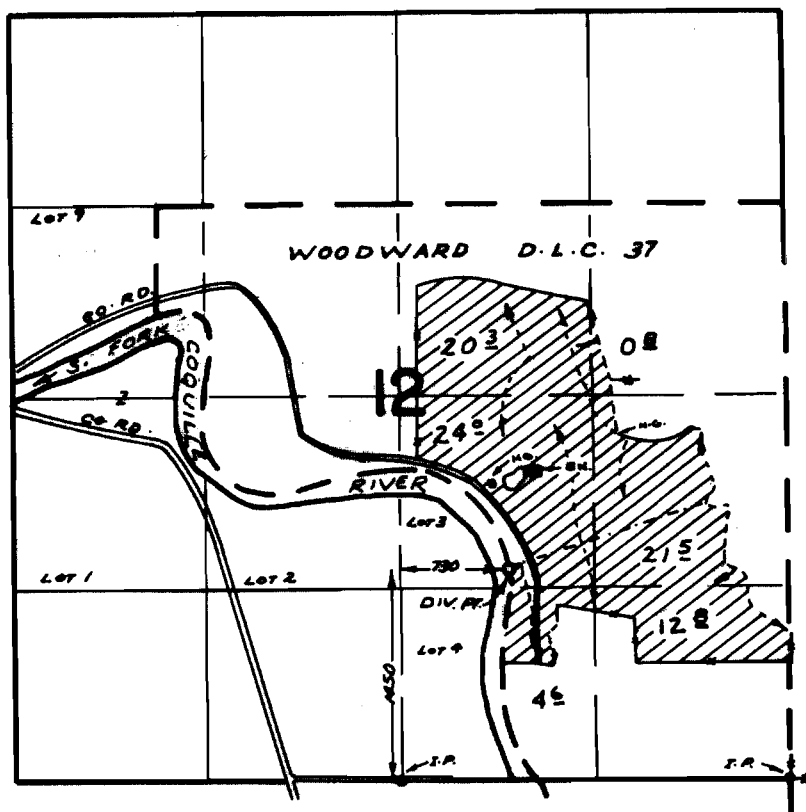

FINAL PROOF SURVEY UNDER

Application No. 1518..... Permit No. 30993.....
IN NAME OF

.....E. ALFRED PEILE.....

Surveyed JULY 11, 1972., by R. MUCKEN