


T. 31S.R.12W.W.M.

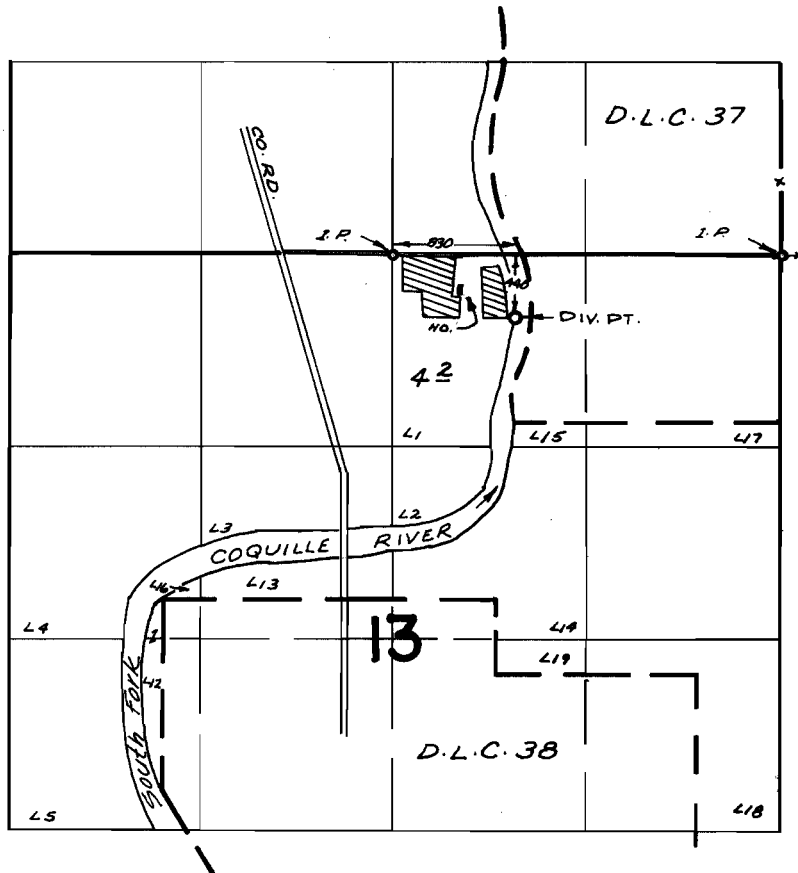

FINAL PROOF SURVEY UNDER

Application No. 41679..... Permit No. 31126.....
IN NAME OF

.....W. R. MERCHEN.....

Surveyed JULY 12, 1972, by R. MUCKEN