


T.24S.R.11W.W.M.

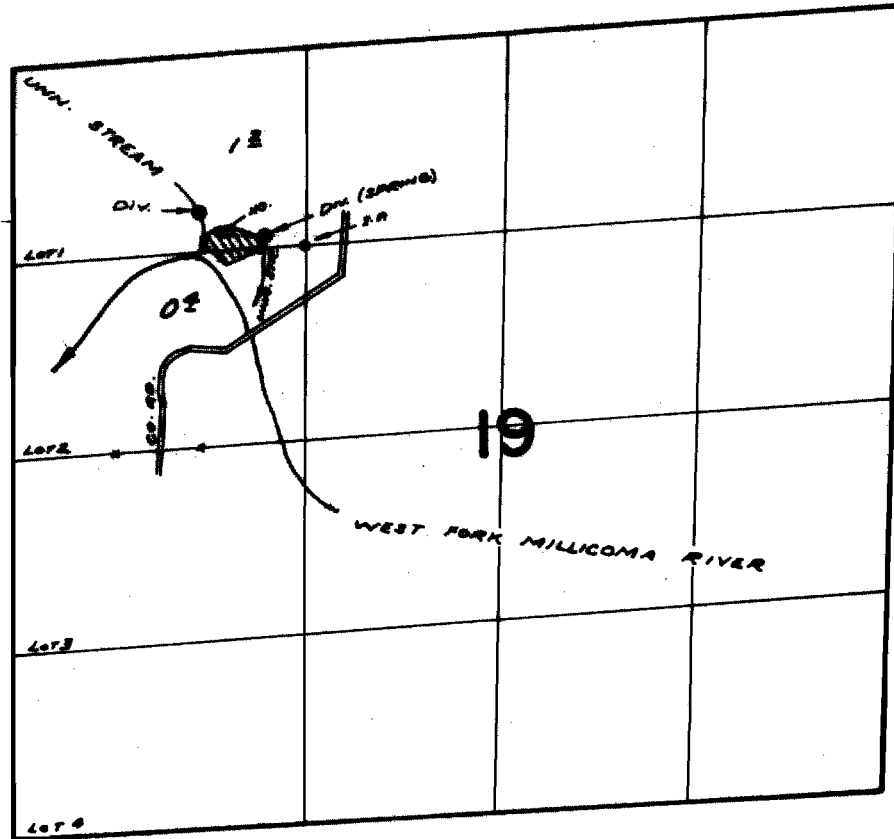

DIV. PTS. LOC: 230' N. 1730' W.; 80' N. 1280' W., BOTH FROM S.E. COR
LOT 1 (NW 1/4 NW 1/4) SEC. 19

FINAL PROOF SURVEY UNDER

Application No. 12085... Permit No. 31527...
IN NAME OF

.....MR. E. A. SMITH.....

Surveyed AUG. 2, 1922., by R. MUCKEN