


T.31S.R.12W.W.M.

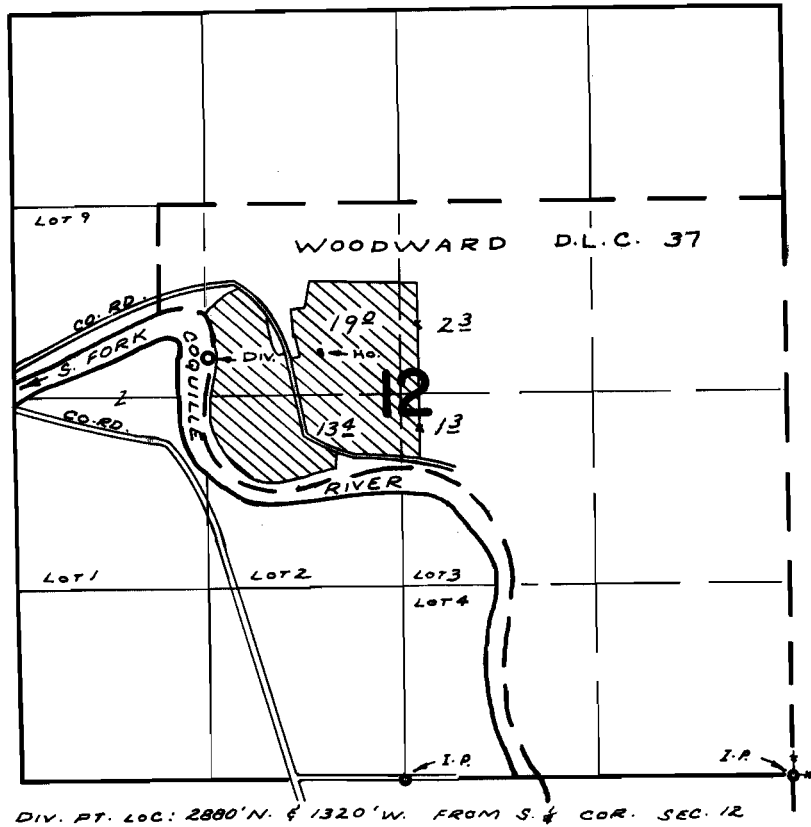

FINAL PROOF SURVEY UNDER

Application No. 42286 Permit No. 31625
IN NAME OF

JOSEPH WILLIAM HARRIS

Surveyed JULY 11 1972, by R. MUCKEN.