


T. 23 S. R 12 W. W.M.

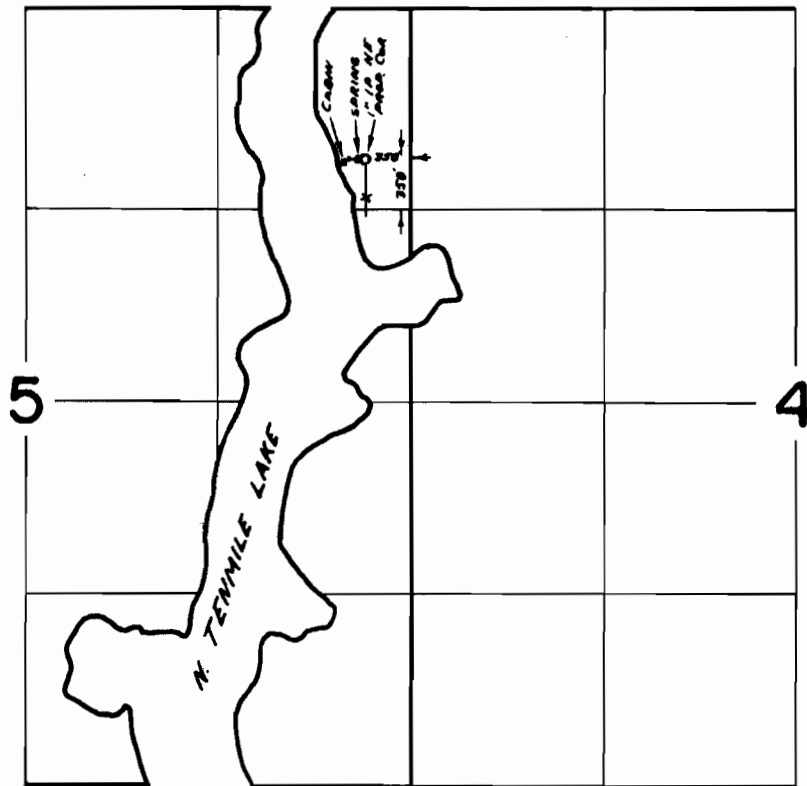

FINAL PROOF SURVEY
UNDER

Application No. 42453 Permit No. 31674
IN NAME OF

DONALD C. & ALICE E. WILSON

Surveyed AUG. 9 1972, by R. G. MUCKEN.