


T.27S., R.14W., W.M.

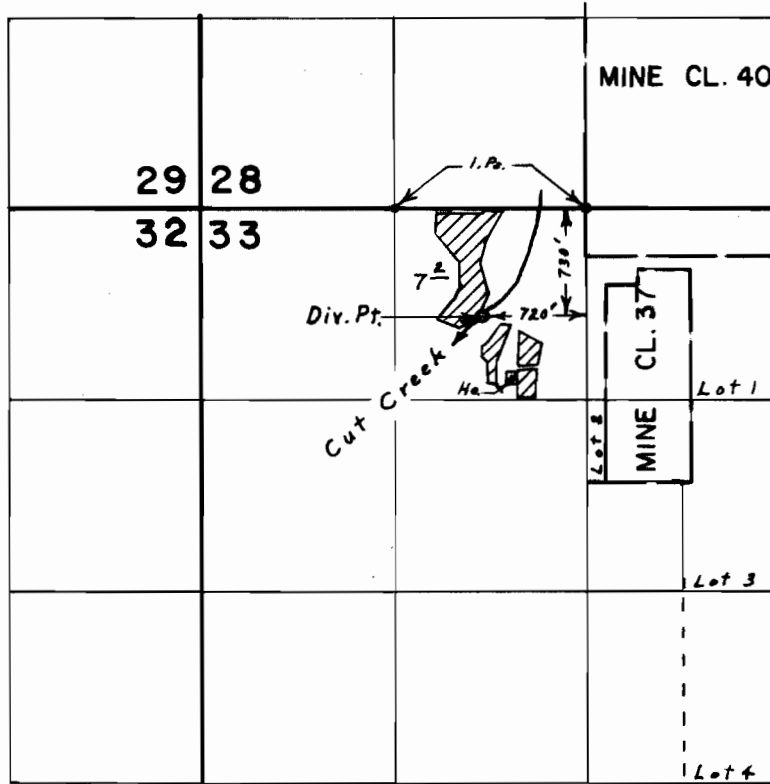

**FINAL PROOF SURVEY**  
UNDER

Application No. 42419 Permit No. 31741  
IN NAME OF

**WAYNE THOMPSON**

Surveyed April 21, 1972, by L. E. Gould