


# T. 29S. R. 12W. W.M.

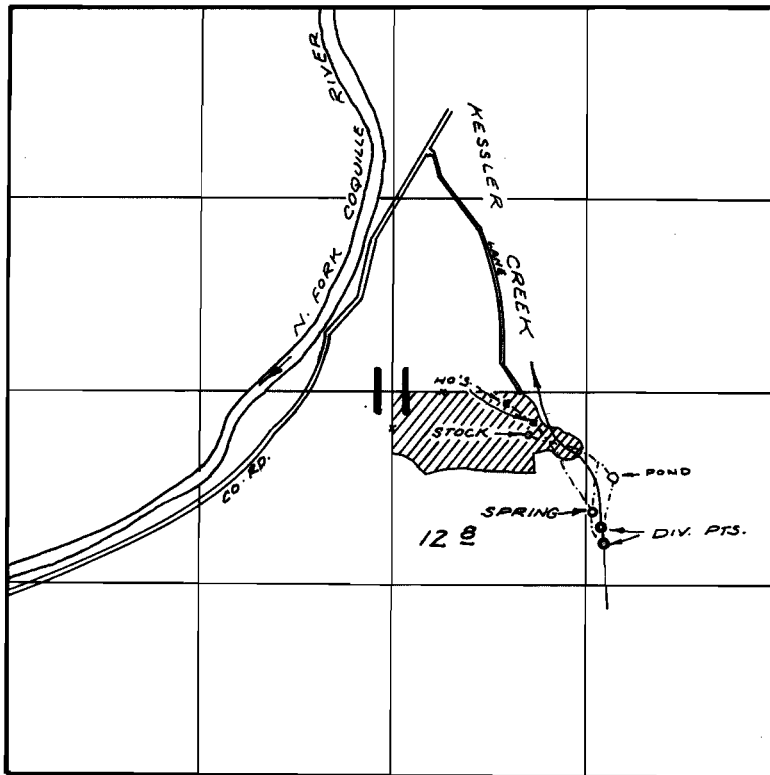

DIV. PTS. LOC - 1040'S. & 1450'E; 920'S. & 1430'E, SPRING - 820'S. & 1380'E., ALL FROM CEN. SEC. 11

## FINAL PROOF SURVEY UNDER

Application No. 42389 Permit No. 31939  
IN NAME OF

JIMMIE A. KING

Surveyed JULY 17, 1972, by R. MUCKEN