


T.29S.R.12W.W.M.

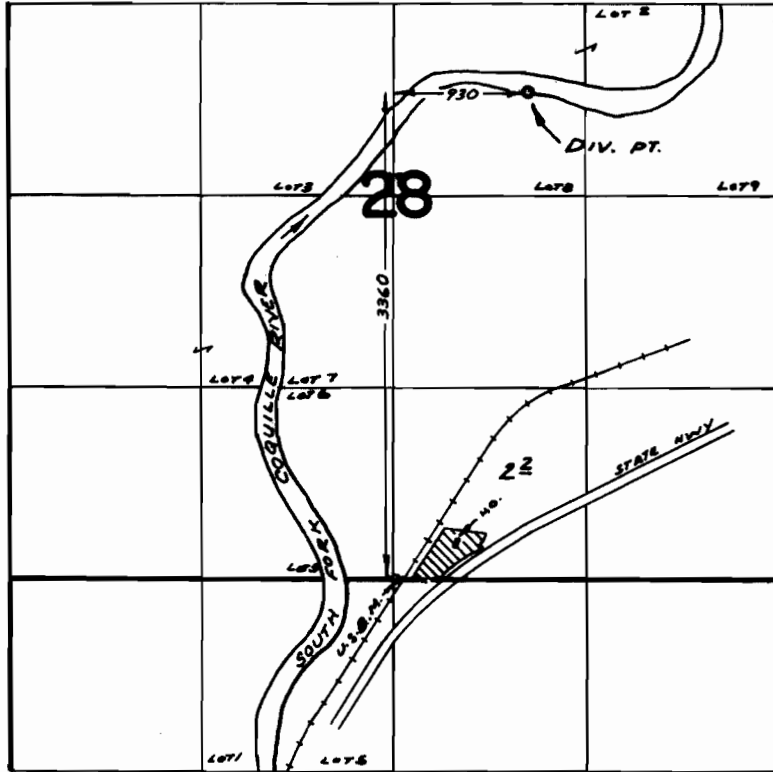

FINAL PROOF SURVEY UNDER

Application No. 43254 Permit No. 32504
IN NAME OF

.....H. B. GILPATRICK.....

Surveyed July 11, 1972, by R. MURKIN