


T.27S.R.13W.W.M.

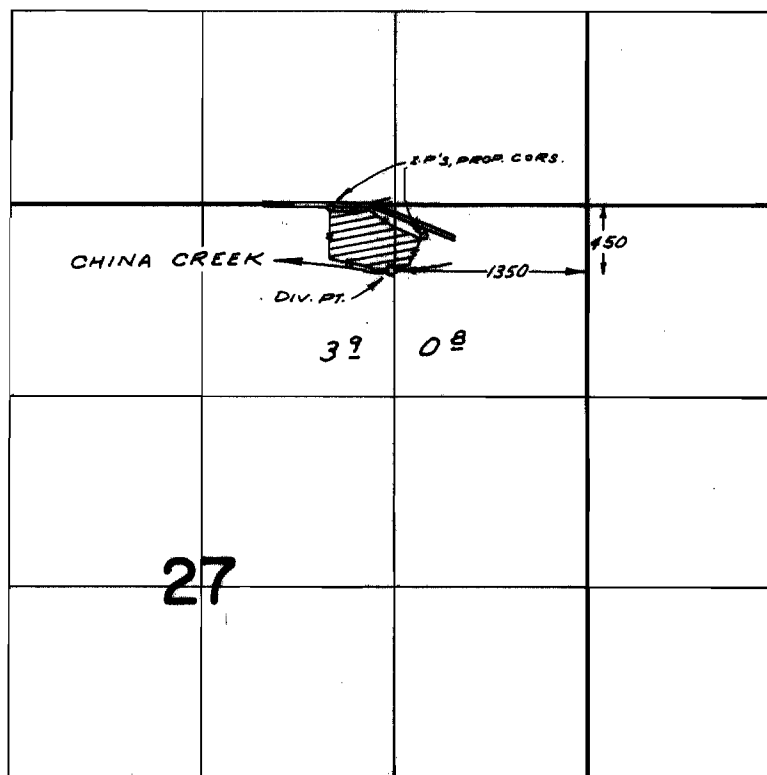

FINAL PROOF SURVEY
UNDER

Application No. 43809 Permit No. 32754
IN NAME OF

HENRY GEORGE ET AL

Surveyed AUG. 4 1972, by R. MUCKEN