


T.27S., R.14W., W.M.

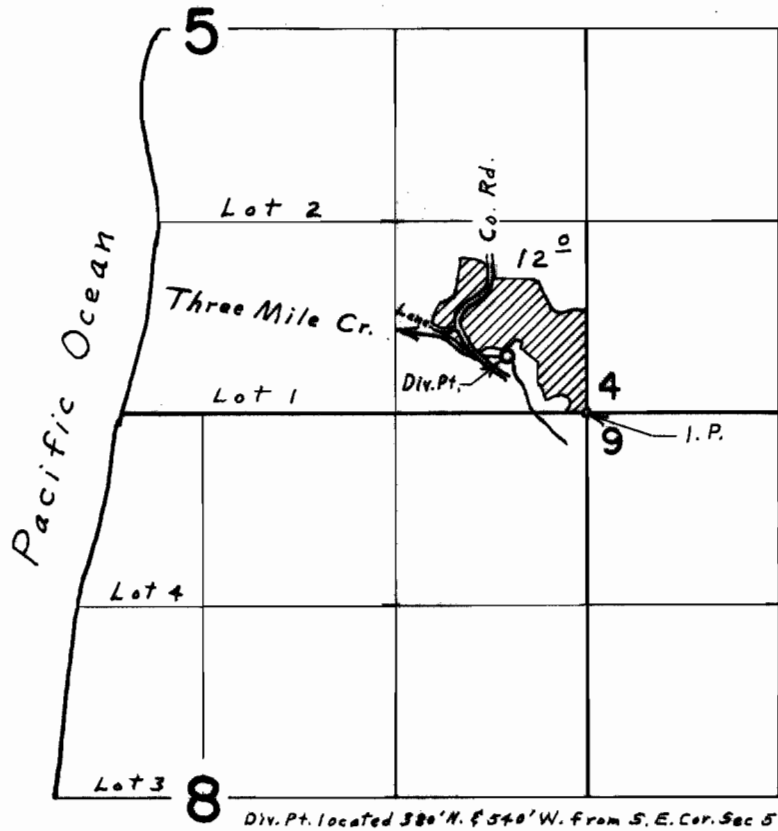

FINAL PROOF SURVEY
UNDER

Application No. 43822 Permit No. 32761
IN NAME OF

J. A. ENYEART, JR.

Surveyed July 12, 1972, by L. E. Gould