


T. 25S. R. 12W. W.M.

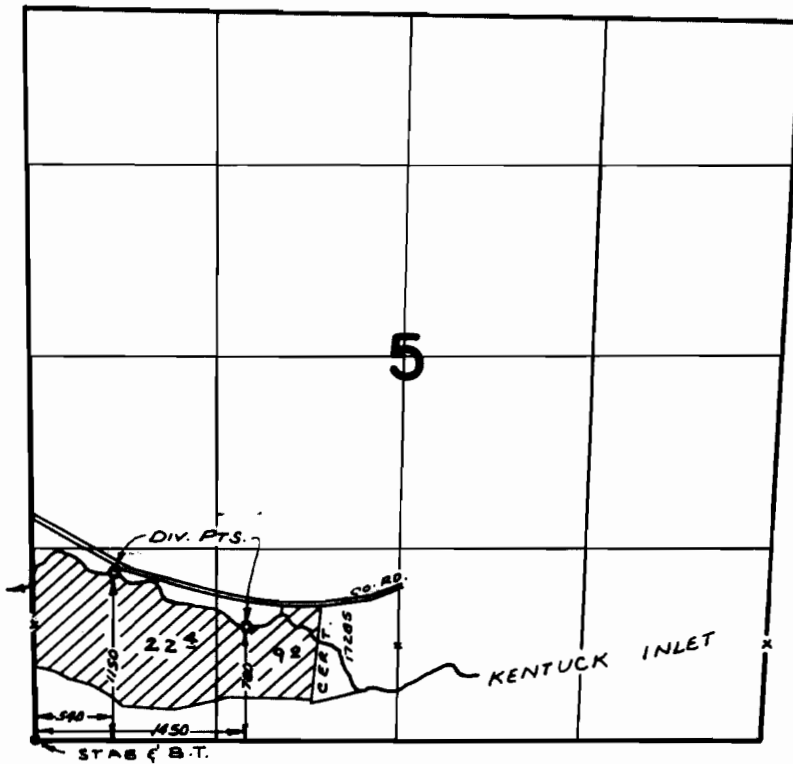

FINAL PROOF SURVEY UNDER

Application No. 45113 Permit No. 33710
IN NAME OF

FRANK B. ROOD

Surveyed AUG. 5, 1972, by R. MUCKEN