


T.30 S.R.11W.W.M.

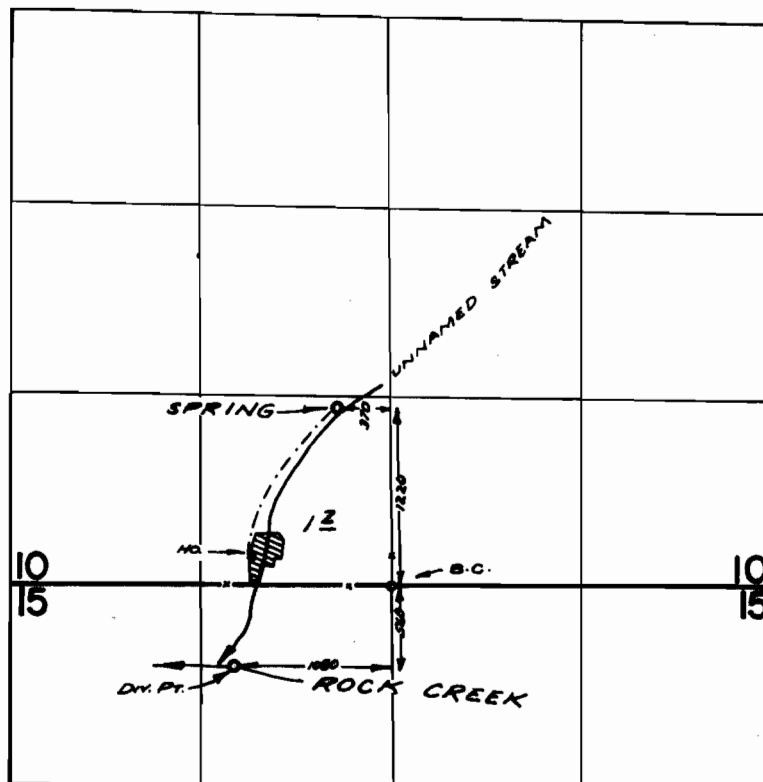

FINAL PROOF SURVEY
UNDER

Application No. 45280 Permit No. 33813
IN NAME OF

MYRON H. GAGE

Surveyed JULY 18 1972, by R. MUCKEN